


(Leow 9/65)

1 LOCATION OF WATER WELL: Fraction SE Section Number 30 Township Number T 4 S Range Number R 7 E/W
 County: Jewell SW 1/4 SW 1/4 NW 1/4

Distance and direction from nearest town or city street address of well if located within city?
620 N. Sheridan, Jewell, Kansas

2 WATER WELL OWNER: Koch Agriculture
 RR#, St. Address, Box # : 4111 E. 37th Street North
 City, State, ZIP Code : Wichita, Kansas 67220
 Board of Agriculture, Division of Water Resources
 Application Number:

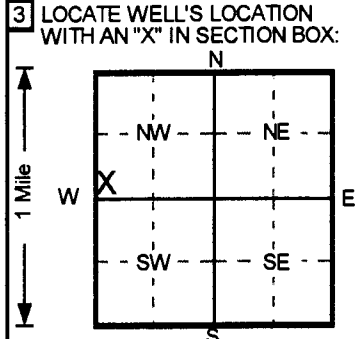

4 DEPTH OF COMPLETED WELL 55 ft. ELEVATION: 999
 Depth(s) Groundwater Encountered 1. ft. 2. ft. 3. ft.
 WELL'S STATIC WATER LEVEL ft. below land surface measured on mo/day/yr
 Pump test data: Well water was NA ft. after hours pumping gpm
 Est. Yield .. NA .. gpm: Well water was ft. after hours pumping gpm
 Bore Hole Diameter 8 in. to 55 ft., and in. to ft.
 WELL WATER TO BE USED AS: 5 Public water supply 8 Air conditioning 11 Injection well
 1 Domestic 3 Feedlot 6 Oil field water supply 9 Dewatering 12 Other (Specify below)
 2 Irrigation 4 Industrial 7 Lawn and garden only 10 Monitoring well
 Was a chemical/bacteriological sample submitted to Department? Yes.....No...; If yes, mo/day/yr sample was submitted
 Water Well Disinfected? Yes No

5 TYPE OF BLANK CASING USED: 5 Wrought iron 8 Concrete tile CASING JOINTS: Glued Clamped
 1 Steel 3 RMP (SR) 6 Asbestos-Cement 9 Other (specify below) Welded
2 PVC 4 ABS 7 Fiberglass Threaded.
 Blank casing diameter 2 in. to 35 ft., Dia in. to ft., Dia in. to ft.
 Casing height above land surface 30 in., weight Sch 40 lbs./ft. Wall thickness or gauge No.
 TYPE OF SCREEN OR PERFORATION MATERIAL 7 PVC 10 Asbestos-cement
 1 Steel 3 Stainless steel 5 Fiberglass 8 RMP (SR) 11 Other (specify)
 2 Brass 4 Galvanized steel 6 Concrete tile 9 ABS 12 None used (open hole)
 SCREEN OR PERFORATION OPENINGS ARE: 5 Gauzed wrapped 8 Saw cut 11 None (open hole)
 1 Continuous slot 3 Mill slot 6 Wire wrapped 9 Drilled holes
 2 Louvered shutter 4 Key punched 7 Torch cut 10 Other (specify)
 SCREEN-PERFORATED INTERVALS: From 35 ft. to 55 ft., From ft. to ft.
 From ft. to ft., From ft. to ft.
 GRAVEL PACK INTERVALS: From 33 ft. to 55 ft., From ft. to ft.
 From ft. to ft., From ft. to ft.

6 GROUT MATERIAL: 1 Neat cement 2 Cement grout 3 Bentonite 4 Other
 Grout intervals: From 0 ft. to 28 ft., From 28 ft. to 33 ft., From ft. to ft.
 What is the nearest source of possible contamination:
 1 Septic tank 4 Lateral lines 7 Pit privy 10 Livestock pens 14 Abandoned water well
 2 Sewer lines 5 Cess pool 8 Sewage lagoon 11 Fuel storage 15 Oil well/Gas well
 3 Watertight sewer lines 6 Seepage pit 9 Feedyard 12 Fertilizer storage 16 Other (specify below)
 13 Insecticide storage Unknown
 Direction from well? How many feet?

FROM	TO	LITHOLOGIC LOG	FROM	TO	PLUGGING INTERVALS
0	0.5	Gravel, Light Gray			10ft/long 39.67620 (W6584)
0.5	4.5	Silt, Dark Brown			- 98.15282
4.5	13	Silt, Light Brown to Brown			from plugging report
13	19	Silt, Reddish Brown			added by VGS
19	20.5	Silt, Greenish Gray			
20.5	23	Silt, Brown			
23	29	Silt, Brown			
29	29.5	Gravel, Off White to Light Gray			
29.5	43.5	Silt, Brown			
43.5	55	Shale, Blue Gray to Black			
					MWJ-4, Tag #, Abovegrade
					Project Name: Envirotech - Jewell
					GeoCore # 717, #

7 CONTRACTOR'S OR LANDOWNER'S CERTIFICATION: This water well was (1) constructed, (2) reconstructed, or (3) plugged under my jurisdiction and was completed on (mo/day/year) 9/25/98 and this record is true to the best of my knowledge and belief.
 Kansas Water Well Contractor's License No. 527 This Water Well Record was completed on (mo/day/yr) 10/21/98
 under the business name of GeoCore Services, Inc. by (signature) Doc Bell

OFFICE USE ONLY
T
R
EW
SEC
%