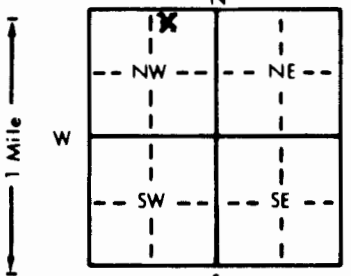


1 LOCATION OF WATER WELL:	Fraction	Section Number	Township Number	Range Number
County: <u>Cloud</u>	<u>NW 1/4 NW 1/4 NE 1/4</u>	<u>5</u>	T <u>5</u> S	R <u>1</u> E

Distance and direction from nearest town or city street address of well if located within city?

4 N 2 W Clyde Kansas

2 WATER WELL OWNER:	Board of Agriculture, Division of Water Resources
RR#, St. Address, Box #:	Application Number:
City, State, ZIP Code:	

3 LOCATE WELL'S LOCATION WITH AN "X" IN SECTION BOX:	4 DEPTH OF COMPLETED WELL: <u>160</u> ft. ELEVATION:
	Depth(s) Groundwater Encountered 1. <u>99</u> ft. 2. <u>118</u> ft. 3. <u>118</u> ft.
	WELL'S STATIC WATER LEVEL <u>80</u> ft. below land surface measured on mo/day/yr
	Pump test data: Well water was <u>50</u> gpm. Well water was <u>160</u> ft. after <u>8</u> hours pumping <u>160</u> gpm
	Bore Hole Diameter <u>8</u> in. to <u>160</u> ft., and <u>160</u> in. to <u>160</u> ft.
	WELL WATER TO BE USED AS:
	1 Domestic 3 Feedlot 6 Oil field water supply 9 Dewatering 12 Other (Specify below)
	2 Irrigation 4 Industrial 7 Lawn and garden only 10 Monitoring well
	Was a chemical/bacteriological sample submitted to Department? Yes <u>X</u> No <u>X</u> If yes, mo/day/yr sample was submitted
	Water Well Disinfected? Yes <u>X</u> No <u>X</u>

5 TYPE OF BLANK CASING USED:	5 Wrought iron	8 Concrete tile	CASING JOINTS: Glued <u>X</u> Clamped
1 Steel	3 RMP (SR)	6 Asbestos-Cement	9 Other (specify below)
2 PVC	4 ABS	7 Fiberglass	Welded
Blank casing diameter <u>5</u> in. to <u>140</u> ft., Dia.			Threaded
Casing height above land surface <u>18</u> in., weight <u>18</u> lbs./ft. Wall thickness or gauge No. <u>251</u>			
TYPE OF SCREEN OR PERFORATION MATERIAL:			
1 Steel	3 Stainless steel	5 Fiberglass	8 RMP (SR)
2 Brass	4 Galvanized steel	6 Concrete tile	9 ABS
SCREEN OR PERFORATION OPENINGS ARE:			
1 Continuous slot	3 Mill slot	5 Gauzed wrapped	8 Saw cut
2 Louvered shutter	4 Key punched	6 Wire wrapped	9 Drilled holes
SCREEN-PERFORATED INTERVALS:			
From <u>140</u> ft. to <u>160</u> ft., From <u>140</u> ft. to <u>160</u> ft.			
GRAVEL PACK INTERVALS:			
From <u>20</u> ft. to <u>160</u> ft., From <u>20</u> ft. to <u>160</u> ft.			

6 GROUT MATERIAL:	1 Neat cement	2 Cement grout	3 Bentonite	4 Other
Grout Intervals:	From <u>0</u> ft. to <u>20</u> ft., From <u>0</u> ft. to <u>20</u> ft.			
What is the nearest source of possible contamination:				
1 Septic tank	4 Lateral lines	7 Pit privy	10 Livestock pens	14 Abandoned water well
2 Sewer lines	5 Cess pool	8 Sewage lagoon	11 Fuel storage	15 Oil well/Gas well
3 Watertight sewer lines	6 Seepage pit	9 Feedyard	12 Fertilizer storage	16 Other (specify below)
			13 Insecticide storage	<u>N/A</u>
Direction from well?			How many feet?	

FROM	TO	LITHOLOGIC LOG	FROM	TO	PLUGGING INTERVALS
0	3	Topsoil			
3	13	Grey clay			
13	36	Loam clay			
36	60	Calico clay			
60	76	gray clay			
76	91	clay w/ sandrock layers			
91	98	sandrock			
98	101	sandrock			
101	105	clay			
105	106	rock (hard)			
106	110	clay			
110	119	sandrock w/ clay layers			
119	160	sandrock			
160		stopped			

7 CONTRACTOR'S OR LANDOWNER'S CERTIFICATION: This water well was (1) constructed, (2) reconstructed, or (3) plugged under my jurisdiction and was completed on (mo/day/year) <u>6-23-95</u> and this record is true to the best of my knowledge and belief. Kansas Water Well Contractor's License No. <u>361</u> This Water Well Record was completed on (mo/day/yr) <u>8-28-95</u> under the business name of <u>Cox Beswick Irrigation</u> by (signature) <u>Annie Beswick</u>
