WATER WELL RECORD Form WWC-5 KSA 82a-1212

1 LOCATION OF WATER WELL: County: ~~CLAY~~ Cloud | Fraction: NE ¼ NW ¼ NW ¼ | Section Number: 21 | Township Number: T 5 S | Range Number: R 1 E (W)

Distance and direction from nearest town or city street address of well if located within city?

2 WATER WELL OWNER: LARRY NOBERT, JR.
RR#, St. Address, Box # : RR 2, Box 193
City, State, ZIP Code : CLYDE, KS 66938

Board of Agriculture, Division of Water Resources
Application Number:

3 LOCATE WELL'S LOCATION WITH AN "X" IN SECTION BOX:

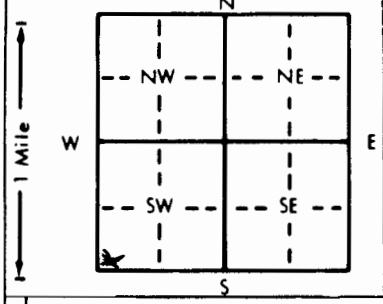

4 DEPTH OF COMPLETED WELL 160 ft. ELEVATION:
Depth(s) Groundwater Encountered 1. ft. 2. ft. 3. ft.
WELL'S STATIC WATER LEVEL 66 ft. below land surface measured on mo/day/yr
Pump test data: Well water was ft. after hours pumping gpm
Est. Yield 20 gpm: Well water was ft. after hours pumping gpm
Bore Hole Diameter 10 in. to 160 ft., and in. to ft.
WELL WATER TO BE USED AS: 5 Public water supply 8 Air conditioning 11 Injection well
(1 Domestic) 3 Feedlot 6 Oil field water supply 9 Dewatering 12 Other (Specify below)
2 Irrigation 4 Industrial 7 Lawn and garden only 10 Monitoring well
Was a chemical/bacteriological sample submitted to Department? Yes No X; If yes, mo/day/yr sample was submitted
Water Well Disinfected? Yes X No

5 TYPE OF BLANK CASING USED: 5 Wrought iron 8 Concrete tile CASING JOINTS: Glued X Clamped
1 Steel 3 RMP (SR) 6 Asbestos-Cement 9 Other (specify below) Welded
(2 PVC) 4 ABS 7 Fiberglass Threaded
Blank casing diameter 0 in. to 104 ft., Dia in. to ft., Dia in. to ft.
Casing height above land surface 24 in., weight Class 200 lbs./ft. Wall thickness or gauge No.

TYPE OF SCREEN OR PERFORATION MATERIAL: (2 PVC) 10 Asbestos-cement
1 Steel 3 Stainless steel 5 Fiberglass 8 RMP (SR) 11 Other (specify)
2 Brass 4 Galvanized steel 6 Concrete tile 9 ABS 12 None used (open hole)

SCREEN OR PERFORATION OPENINGS ARE: 5 Gauzed wrapped (8 Saw cut) 11 None (open hole)
1 Continuous slot 3 Mill slot 6 Wire wrapped 9 Drilled holes
2 Louvered shutter 4 Key punched 7 Torch cut 10 Other (specify)

SCREEN-PERFORATED INTERVALS: From 104 ft. to 160 ft., From ft. to ft.
From ft. to ft., From ft. to ft.
GRAVEL PACK INTERVALS: From 160 ft. to 20 ft., From ft. to ft.
From ft. to ft., From ft. to ft.

6 GROUT MATERIAL: 1 Neat cement 2 Cement grout (3 Bentonite) 4 Other Clay Back Fill
Grout Intervals: From 0 ft. to 20 ft., From ft. to ft., From ft. to ft.

What is the nearest source of possible contamination:
(1 Septic tank) 4 Lateral lines 7 Pit privy 10 Livestock pens (14 Abandoned water well) 40'
(2 Sewer lines) 5 Cess pool 8 Sewage lagoon 11 Fuel storage 15 Oil well/Gas well
3 Watertight sewer lines 6 Seepage pit (9 Feedyard) ~200' 12 Fertilizer storage 16 Other (specify below)
13 Insecticide storage
Direction from well? West How many feet? 250'

FROM	TO	LITHOLOGIC LOG	FROM	TO	PLUGGING INTERVALS
0	2	Top soil			
2	38	Clay			
38	50	Sandstone			
50	87	Red Beds, clay			
87	113	Rock layer & Red Beds			
113	164	Sandstone			

7 CONTRACTOR'S OR LANDOWNER'S CERTIFICATION: This water well was (1) constructed, (2) reconstructed, or (3) plugged under my jurisdiction and was completed on (mo/day/year) 5/3/96 and this record is true to the best of my knowledge and belief. Kansas Water Well Contractor's License No. 480 This Water Well Record was completed on (mo/day/yr) 5/30/96
under the business name of WILLIAMS DRILLING CO. INC. by (signature) Don Williams

INSTRUCTIONS: Use typewriter or ball point pen. *PLEASE PRESS FIRMLY* and *PRINT* clearly. Please fill in blanks, underline or circle the correct answers. Send top three copies to Kansas Department of Health and Environment, Bureau of Water, Topeka, Kansas 66620-0001. Telephone: 913-296-5545. Send one to WATER WELL OWNER and retain one for your records.