


1 LOCATION OF WATER WELL: Fraction SE 1/4 SE 1/4 SE 1/4 Section Number 26 Township Number T 5 S Range Number R 1 EAST
 County: CLOUD

Distance and direction from nearest town or city street address of well if located within city?
1-BLOCK EAST OF GRANT - 1-BLOCK SOUTH OF WASHINGTON ST CLYDE KS.

2 WATER WELL OWNER: CLYDE COOP ELEVATOR ASSOC
 RR#, St. Address, Box # : 426 WASHINGTON ST. CLYDE KS. 66938 Board of Agriculture, Division of Water Resources
 City, State, ZIP Code : Application Number:

3 LOCATE WELL'S LOCATION WITH AN "X" IN SECTION BOX:

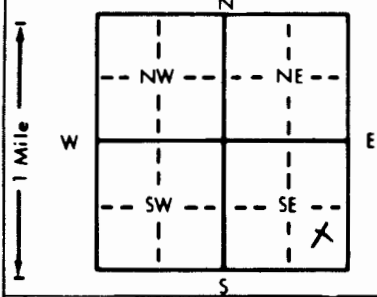

4 DEPTH OF COMPLETED WELL: 32 ft. ELEVATION: 80.7 1295.80
 Depth(s) Groundwater Encountered 1. 23.5 ft. 2. — ft. 3. — ft.
 WELL'S STATIC WATER LEVEL 22.92 ft. below land surface measured on mo/day/yr 06-10-93
 Pump test data: Well water was NA ft. after — hours pumping — gpm
 Est. Yield NA gpm: Well water was — ft. after — hours pumping — gpm
 Bore Hole Diameter: 7.25 in. to 35 in. and — in. to — in.
 WELL WATER TO BE USED AS: 5 Public water supply 8 Air conditioning 11 Injection well
 1 Domestic 3 Feedlot 6 Oil field water supply 9 Dewatering 12 Other (Specify below)
 2 Irrigation 4 Industrial 7 Lawn and garden only 10 Monitoring well
 Was a chemical/bacteriological sample submitted to Department? Yes — No X; If yes, mo/day/yr sample was submitted —
 Water Well Disinfected? Yes — No X

5 TYPE OF BLANK CASING USED: 5 Wrought iron 8 Concrete tile CASING JOINTS: Glued — Clamped —
 1 Steel 3 RMP (SR) 6 Asbestos-Cement 9 Other (specify below) Welded —
2 PVC 4 ABS 7 Fiberglass Threaded X
 Blank casing diameter 2 in. to 17 ft., Dia — in. to — ft., Dia — in. to — ft.
 Casing height above land surface 24 in., weight 50440 lbs./ft. Wall thickness or gauge No. —

TYPE OF SCREEN OR PERFORATION MATERIAL: 2 PVC 10 Asbestos-cement
 1 Steel 3 Stainless steel 5 Fiberglass 8 RMP (SR) 11 Other (specify) —
 2 Brass 4 Galvanized steel 6 Concrete tile 9 ABS 12 None used (open hole)

SCREEN OR PERFORATION OPENINGS ARE: 5 Gauzed wrapped 8 Saw cut 11 None (open hole)
 1 Continuous slot 3 Mill slot 6 Wire wrapped 9 Drilled holes
 2 Louvered shutter 4 Key punched 7 Torch cut 10 Other (specify) —

SCREEN-PERFORATED INTERVALS: From 17 ft. to 32 ft., From — ft. to — ft.
 From — ft. to — ft., From — ft. to — ft.
~~GRAVEL~~ SAND PACK INTERVALS: From 16 ft. to 35 ft., From — ft. to — ft.
 From — ft. to — ft., From — ft. to — ft.

6 GROUT MATERIAL: 1 Neat cement 2 Cement grout 3 Bentonite 4 Other BENTONITE GROUT
 Grout Intervals: From 4 3 ft. to 15 ft., From 3 15 ft. to 16 ft., From — ft. to — ft.

What is the nearest source of possible contamination:
 1 Septic tank 4 Lateral lines 7 Pit privy 10 Livestock pens 14 Abandoned water well
 2 Sewer lines 5 Cess pool 8 Sewage lagoon 11 Fuel storage 15 Oil well/Gas well
 3 Watertight sewer lines 6 Seepage pit 9 Feedyard 12 Fertilizer storage 16 Other (specify below) CONTAMINATED SITE
 13 Insecticide storage
 Direction from well? ← How many feet? —

FROM	TO	LITHOLOGIC LOG	FROM	TO	PLUGGING INTERVALS
<u>GL</u>	<u>2.5</u>	<u>TOP SOIL</u>			
<u>2.5</u>	<u>20</u>	<u>SILTY CLAY - TR OF FINE SD</u>			
<u>20</u>	<u>20.5</u>	<u>SILTY SAND</u>			
<u>20.5</u>	<u>23.5</u>	<u>SILTY CLAY</u>			
<u>23.5</u>	<u>25</u>	<u>SILTY SAND WATER 23.5</u>			
<u>25</u>	<u>35</u>	<u>SAND - GRADES FROM FIVE TO MED GRAIN AT 35'</u>			

7 CONTRACTOR'S OR LANDOWNER'S CERTIFICATION: This water well was (1) constructed, (2) reconstructed, or (3) plugged under my jurisdiction and was completed on (mo/day/year) 06-07-93 and this record is true to the best of my knowledge and belief. Kansas Water Well Contractor's License No. 479 This Water Well Record was completed on (mo/day/yr) 07-01-93 under the business name of EBBERTS DRILLING by (signature) Logan Elbert

INSTRUCTIONS: Use typewriter or ball point pen. PLEASE PRESS FIRMLY and PRINT clearly. Please fill in blanks, underline or circle the correct answers. Send top three copies to Kansas Department of Health and Environment, Bureau of Water, Topeka, Kansas 66620-0001. Telephone: 913-296-5545. Send one to WATER WELL OWNER and retain one for your records.