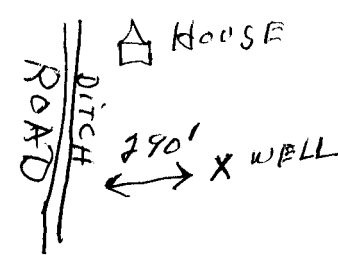


USE TYPEWRITER OR BALL POINT PEN-PRESS FIRMLY, PRINT CLEARLY.

WATER WELL RECORD  
KSA 82a-1201-1215

Kansas Department of Health and Environment-Division of Environment (Water well Contractors)  
Topeka, Kansas 66620

1. Location of well:	County <b>SMITH</b>	Fraction <b>NW 1/4 NW 1/4 NW 1/4</b>	Section number <b>31</b>	Township number T <b>5</b> S R <b>12</b> <span style="float:right;">(E/W)</span>	Range number
2. Distance and direction from nearest town or city: Street address of well location if in city:			3. Owner of well: R.R. or street: City, state, zip code:		
2. Distance and direction from nearest town or city: <b>3 W 1 N</b> Street address of well location if in city: <b>OF PORTIS KAN.</b>			3. Owner of well: <b>CLARENCE HENDRICH</b> R.R. or street: <b>RR 1</b> City, state, zip code: <b>PORTIS KAN 67474</b>		
4. Locate with "X" in section below: N W E S 1 Mile		Sketch map: 		6. Bore hole dia. <b>3 1/4</b> in. Completion date <del>7-10-78</del> Well depth <b>51</b> ft.	
5. Type and color of material		From		To	
		TOP SOIL		1 2	
		CLAY		2 40	
		RED SAND		40 51	
				7. Cable tool <input type="checkbox"/> Rotary <input type="checkbox"/> Driven <input type="checkbox"/> Dug <input type="checkbox"/> Hollow rod <input type="checkbox"/> Jetted <input type="checkbox"/> Bored <input checked="" type="checkbox"/> Reverse rotary	
				8. Use: <input type="checkbox"/> Domestic <input type="checkbox"/> Public supply <input type="checkbox"/> Industry <input checked="" type="checkbox"/> Irrigation <input type="checkbox"/> Air conditioning <input type="checkbox"/> Stock <input type="checkbox"/> Lawn <input type="checkbox"/> Oil field water <input type="checkbox"/> Other	
				9. Casing: Material <b>CA</b> Height: <b>Above</b> or below Threaded <b>DAN</b> Welded <input type="checkbox"/> Surface <b>12</b> in. RMP <input type="checkbox"/> PVC <input type="checkbox"/> Weight <input type="checkbox"/> lbs./ft. Dia. <b>16</b> in. to <b>38</b> ft. depth Wall Thickness: inches or Dia. <input type="checkbox"/> in. to <input type="checkbox"/> ft. depth Gage No. <b>1 1/2</b>	
				10. Screen: Manufacturer's name <b>JOHNSONS</b> Type <b>CRS</b> Dia. <b>16</b> Slot/gauze <b>1/8"</b> Length <b>13'</b> Set between <b>38</b> ft. and <b>51</b> ft. ft. and <input type="checkbox"/> ft. Gravel pack? <input checked="" type="checkbox"/> Size range of material <b>5/16"</b>	
				11. Static water level: <input type="checkbox"/> mo./day/yr. <b>29</b> ft. below land surface Date <b>7-5-78</b>	
				12. Pumping level below land surfaces: <input type="checkbox"/> ft. after <input type="checkbox"/> hrs. pumping <input type="checkbox"/> g.p.m. <input type="checkbox"/> ft. after <input type="checkbox"/> hrs. pumping <input type="checkbox"/> g.p.m. Estimated maximum yield <b>600</b> g.p.m.	
				13. Water sample submitted: <input type="checkbox"/> mo./day/yr. Yes <input checked="" type="checkbox"/> No Date	
				14. Well head completion: <input type="checkbox"/> Pitless adapter <b>12</b> inches above grade	
				15. Well grouted? <b>YES</b> With: <input type="checkbox"/> Neat cement <input type="checkbox"/> Bentonite <input checked="" type="checkbox"/> Concrete Depth: From <b>1</b> ft. to <b>12</b> ft.	
				16. Nearest source of possible contamination: ft. <b>290</b> Direction <b>W</b> Type <b>DITCH</b> Well disinfected upon completion? <input type="checkbox"/> Yes <input checked="" type="checkbox"/> No	
				17. Pump: <input type="checkbox"/> Not installed Manufacturer's name <b>Western Iron Roller</b> Model number <input type="checkbox"/> HP <input type="checkbox"/> Volts <input type="checkbox"/> Length of drop pipe <b>50</b> ft. capacity <b>700</b> g.p.m. Type: <input type="checkbox"/> Submersible <input checked="" type="checkbox"/> Turbine <input type="checkbox"/> Jet <input type="checkbox"/> Reciprocating <input type="checkbox"/> Centrifugal <input type="checkbox"/> Other	
				(Use a second sheet if needed)	
18. Elevation:		19. Remarks:		20. Water well contractor's certification: This well was drilled under my jurisdiction and this report is true to the best of my knowledge and belief. <b>D &amp; D Service</b> <b>108</b> Business name License No. Address <b>Downs Kan.</b> Signed <b>Wendell DeBey</b> Date <b>8-1-78</b> Authorized representative	
Topography: <input type="checkbox"/> Hill <input checked="" type="checkbox"/> Slope <input type="checkbox"/> Upland <input type="checkbox"/> Valley					

12  
 31  
 1/4 1/4 1/4  
 N.W. 1/4  
 Sec