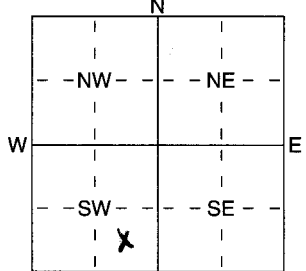


1 LOCATION OF WATER WELL: Fraction SE 1/4 SW 1/4 Section Number 4 Township Number T 5 S Range Number R 13 E 10  
 County: Smith

Distance and direction from nearest town or city street address of well if located within city?  
GPS - 39 33 46.2 = 098 49 05.1

2 WATER WELL OWNER: Kendall Nichols  
 RR#, St. Address, Box # : Rt 2 Board of Agriculture, Division of Water Resources  
 City, State, ZIP Code : Smith Center, KS 666967 Application Number:

3 LOCATE WELL'S LOCATION WITH AN "X" IN SECTION BOX:  
  
 4 DEPTH OF COMPLETED WELL 55 ft. ELEVATION:  
 Depth(s) Groundwater Encountered 1 ..... ft. 2 ..... ft. 3 ..... ft.  
 WELL'S STATIC WATER LEVEL 20 ft. below land surface measured on mo/day/yr  
 Pump test data: Well water was an dwp ft. after ..... hours pumping ..... gpm  
 Est. Yield 20 gpm: Well water was ..... ft. after ..... hours pumping ..... gpm  
 WELL WATER TO BE USED AS: 5 Public water supply 8 Air conditioning 11 Injection well  
 Domestic 3 Feedlot 6 Oil field water supply 9 Dewatering 12 Other (Specify below)  
 2 Irrigation 4 Industrial 7 Domestic (lawn & garden) 10 Monitoring well  
 Was a chemical/bacteriological sample submitted to Department? Yes ..... No X .....; If yes, mo/day/yr sample was sub-  
 mitted Water Well Disinfected? Yes No

5 TYPE OF BLANK CASING USED:  
 1 Steel 3 RMP (SR) 5 Wrought iron 8 Concrete tile CASING JOINTS: Glued X Clamped .....  
 PVC 4 ABS 7 Fiberglass 9 Other (specify below) Welded .....  
 Blank casing diameter 5 in. to 31 ft., Dia 5 in. to 55 ft., Dia ..... in. to ..... ft.  
 Casing height above land surface 12 in., weight ..... lbs./ft. Wall thickness or gauge No. 2.14  
 TYPE OF SCREEN OR PERFORATION MATERIAL:  
 1 Steel 3 Stainless Steel 5 Fiberglass  PVC 10 Asbestos-Cement  
 2 Brass 4 Galvanized Steel 6 Concrete tile 8 RMP (SR) 11 Other (Specify) .....  
 9 ABS 12 None used (open hole)  
 SCREEN OR PERFORATION OPENINGS ARE:  
 1 Continuous slot 3 Mill slot 5 Guazed wrapped  Saw cut 11 None (open hole)  
 2 Louvered shutter 4 Key punched 6 Wire wrapped 9 Drilled holes  
 7 Torch cut 10 Other (specify) ..... ft.  
 SCREEN-PERFORATED INTERVALS: From 31 ft. to 51 ft., From ..... ft. to ..... ft.  
 From ..... ft. to ..... ft., From ..... ft. to ..... ft.  
 GRAVEL PACK INTERVALS: From 20 ft. to 55 ft., From ..... ft. to ..... ft.  
 From ..... ft. to ..... ft., From ..... ft. to ..... ft.

6 GROUT MATERIAL: 1 Neat cement 2 Cement grout  Bentonite 4 Other .....  
 Grout Intervals: From 0 ft. to 20 ft., From ..... ft. to ..... ft., From ..... ft. to ..... ft.  
 What is the nearest source of possible contamination:  
 1 Septic tank 4 Lateral lines 7 Pit privy 10 Livestock pens 14 Abandoned water well  
 2 Sewer lines 5 Cess pool 8 Sewage lagoon 11 Fuel storage 15 Oil well/Gas well  
 3 Watertight sewer lines 6 Seepage pit 9 Feedyard 12 Fertilizer storage 16 Other (specify below)  
 13 Insecticide storage none  
 Direction from well? How many feet?

FROM	TO	LITHOLOGIC LOG	FROM	TO	PLUGGING INTERVALS
0	15	Topsoil & Clay			
15	20	Tan Clay w/ Limestone			
20	40	Blue Clay			
40	49	Blue clay w/sand			
49	55	Shale			

7 CONTRACTOR'S OR LANDOWNER'S CERTIFICATION: This water well was  constructed, (2) reconstructed, or (3) plugged under my jurisdiction and was completed on (mo/day/year) 8/2/05 and this record is true to the best of my knowledge and belief. Kansas Water Well Contractor's Licence No 741 This Water Well Record was completed on (mo/day/yr) 9/1/05 under the business name of Water Well Drilling by (signature) Eddie Watson