


1	LOCATION OF WATER WELL: County: <u>Smith</u>	Fraction <u>NE</u> $\frac{1}{4}$ $\frac{1}{4}$ $\frac{1}{4}$	Section Number <u>35</u>	Township Number <u>5</u>	Range Number <u>13</u>
---	---	---	-----------------------------	-----------------------------	---------------------------

Distance and direction from nearest town or city street address of well if located within city?  
NA

2	WATER WELL OWNER: <u>Kendall E. Nichols</u> RR #, St. Address, Box #: <u>17081 300 Road</u> City, State, ZIP Code: <u>Harlan, KS 66947</u>	Board of Agriculture, Division of Water Resources Application Number: <u>024717</u>
---	--	--

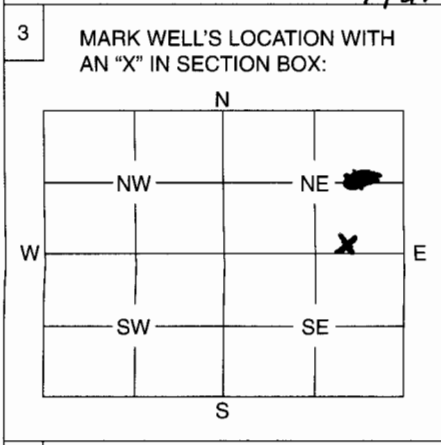

4 DEPTH OF WELL ..... 6.7 ..... ft.  
WELL'S STATIC WATER LEVEL ..... 4.7 ..... ft.

WELL WAS USED AS:

1 Domestic	5 Public Water Supply	9 Dewatering
2 Irrigation	6 Oil Field Water Supply	10 Monitoring Well
3 Feedlot	7 Domestic (Lawn & Garden)	11 Injection Well
4 Industrial	8 Air Conditioning	12 Other .....

*used only about 3 years as did not prove-out,*

Was a chemical / bacteriological sample submitted to Department? Yes ..... No

If yes, mo/day/yr sample was submitted .....

Water Well Disinfected: Yes  No .....

5 TYPE OF BLANK CASING USED:

1 Steel	3 RMP (SR)	5 Wrought	7 Fiberglass	9 Other (Specify below)
2 PVC	4 ABS	6 Asbestos-Cement	8 Concrete Tile	<u>transite</u>

Blank casing diameter ... 1.8 ... in. Was casing pulled? Yes  No  If yes, how much Top 8'

Casing height above or below land surface ... 8' ... in.

6 GROUT PLUG MATERIAL: 1 Neat cement 2 Cement grout 3 Bentonite 4 Other .....

Grout Plug Intervals: From ..... ft. to ..... ft. From ..... ft. to ..... ft. From ..... to ..... ft.

What is the nearest source of possible contamination:  
7 Boop of Bentonite starting @ 8' depth.

1 Septic tank	6 Seepage pit	11 Fuel storage	16 Other (specify below)
2 Sewer lines	7 Pit privy	12 Fertilizer storage	<u>none - @ edge</u>
3 Watertight sewer lines	8 Sewage lagoon	13 Insecticide storage	<u>of field w/pasture</u>
4 Lateral lines	9 Feedyard	14 Abandoned water well	<u>across the fence</u>
5 Cess pool	10 Livestock pens	15 Oil well/Gas well	

Direction from well? Domestic How many feet? about 1/2 mile & 1/2 mile  
is about 1/2 mile

FROM	TO	PLUGGING MATERIALS
<u>67</u>	<u>50 ft.</u>	<u>Sand (5 gal. Chlorox paint sand)</u>
<u>50</u>	<u>59</u>	<u>Blow Sand</u>
<u>59</u>	<u>to 70</u>	<u>Adjacent Soil</u>

7 CONTRACTOR'S OF LANDOWNER'S CERTIFICATION: This water well was plugged under my jurisdiction and was completed on (mo/day/year) 4/9/09 and this record is true to the best of my knowledge and belief. Kansas Water Well Contractor's License No. NA - did it myself This Water Well Record was completed on (mo/day/year) ..... under the business name of 4/13/09 - personal / Kendall E. Nichols by (signature) Kendall E. Nichols

INSTRUCTIONS: Use typewriter or ball point pen. Please press firmly and print clearly. Please fill in blanks, underline or circle the correct answers. Send top three copies to Kansas Department of Health and Environment, Bureau of Water, Geology Section, 1000 SW Jackson St., Ste. 420, Topeka, Kansas 66612-1367. Telephone: 785/296-5522. Send one to Water Well Owner and retain one for your records.