USE TYPEWRITER OR BALL POINT PEN-PRESS FIRMLY, PRINT CLEARLY.

WATER WELL RECORD
KSA 82a-1201-1215

Kansas Department of Health and Environment-Division of Environment
(Water well Contractors)
Topeka, Kansas 66620

1. Location of well:	County	Fraction	Section number	Township number	Range number
	SMITH	NW 1/4 NW 1/4 NW 1/4	16	T 5 S	R 13 E/W

2. Distance and direction from nearest town or city: 2 E. 1S. OF GAYLORD KS.
Street address of well location if in city:

3. Owner of well: STEVE SCHMIDT
R.R. or street: RR-2
City, state, zip code: SMITH CENTER KS 66967

4. Locate with "X" in section below:

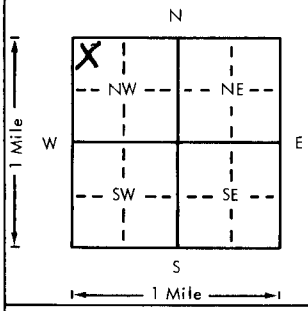

Sketch map:

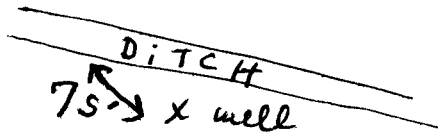

6. Bore hole dia. 34 in. Completion date 10-5-79
Well depth 53 ft.

7. __ Cable tool __ Rotary __ Driven __ Dug
__ Hollow rod __ Jetted __ Bored X Reverse rotary

8. Use: __ Domestic __ Public supply __ Industry
X Irrigation __ Air conditioning __ Stock
__ Lawn __ Oil field water __ Other

9. Casing: Material C.A. Height: Above or below
Threaded BAND Welded ____ Surface 14 in.
RMP [redacted] PVC ____ Weight ____ lbs./ft.
Dia. 16 in. to 40 ft. depth Wall Thickness: inches or
Dia. ____ in. to ____ ft. depth gage No. 1"

10. Screen: Manufacturer's name JOHNSONS
Type Cont Asb. Dia. 16
Slot/gauze 16 Length 13'
Set between 40 ft. and 53 ft.
____ ft. and ____ ft.
Gravel pack? YES Size range of material 1/4

11. Static water level: mo./day/yr.
18 ft. below land surface Date 8-10-79

12. Pumping level below land surfaces:
____ ft. after ____ hrs. pumping ____ g.p.m.
____ ft. after ____ hrs. pumping ____ g.p.m.
Estimated maximum yield 1500 g.p.m.

13. Water sample submitted: mo./day/yr.
__ Yes __ No Date ____

14. Well head completion:
__ Pitless adapter ____ Inches above grade

15. Well grouted? YES
With: __ Neat cement __ Bentonite X Concrete
Depth: From 2 ft. to 14 ft.

16. Nearest source of possible contamination:
ft. 75 Direction N Type DITCH
Well disinfected upon completion? ____ Yes X No

17. Pump: __ Not installed
Manufacturer's name W. LAND ROLLER
Model number ____ HP ____ Volts ____
Length of drop pipe 52 ft. capacity 1000 g.p.m.
Type:
__ Submersible X Turbine
__ Jet __ Reciprocating
__ Centrifugal __ Other

5. Type and color of material	From	To
TOPSOIL	1	2
CLAY BROWN	2	15
COARSE, SAND RED	15	53

(Use a second sheet if needed)

18. Elevation:
Topography:
__ Hill
__ Slope
__ Upland
X Valley

19. Remarks:

20. Water well contractor's certification:
This well was drilled under my jurisdiction and this report is true to the best of my knowledge and belief.
D&D Service 108
Business name License No.
Address DOWNS KAN.
Signed Wendell DeBey Date 10-10-79
Authorized representative

T 5 R 13 E/W Sec 16 1/4 NWNW 1/4 1/4

Forward the white, blue and pink copies to the Department of Health and Environment

Form WWC-5