

USE TYPEWRITER OR BALL
POINT PEN-PRESS FIRMLY,
PRINT CLEARLY.

513 W 20 NE W 5W
T R EW sec 1/4 1/4 1/4 No.


WATER WELL RECORD
KSA 82a-1201-1215

Kansas State Dept. of Health
(Water Well Contractors)
Forbes-Bldg. 740
Topeka, Kansas 66620

1 Location of well:	County <u>Smith</u>	Township name <u>Horton</u>	Fraction <u>NE 1/4 Sec 20</u>	Section number <u>20</u>	Town number <u>5</u>	Range number <u>13</u>
---------------------	---------------------	-----------------------------	-------------------------------	--------------------------	----------------------	------------------------

Distance and direction from nearest town or city: 3 E 2 3 S
Street address of well location if in city: Goosland, Kan.

3 Owner of well: PERRY SWEET
Address: Smith Center, Kan.

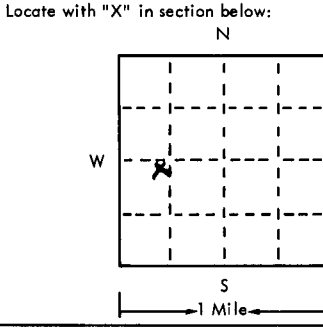

4 Well depth: 65 ft. Date of completion 6-1-28
Well diameter 1 1/2 in.

5 Cable tool Rotary Driven Dug
 Hollow rod Jetted Bored Reverse rotary

6 Use: Domestic Public supply Industry
 Irrigation Air conditioning Commercial
 Test well

7 Casing: Material CA Height: above/below
Threaded Welded Surface 12 in.
Diam. Weight 30 lbs./ft.
1 1/2 in. to 65 ft. depth Drive shoe? Yes No
in. to _____ ft. depth

2	Type and color of material	From	To
	<u>clay brown</u>	<u>0</u>	<u>13</u>
	<u>gravel med brown</u>	<u>13</u>	<u>28</u>
	<u>Blue mud sand mixed</u>	<u>28</u>	<u>48</u>
	<u>gravel black white med</u>	<u>48</u>	<u>64</u>
	<u>blue shale</u>	<u>64</u>	<u>65</u>

8 Screen: Johanson casings
Manufacturer Johanson
Type 3/8 slot Dia. 1 1/2"
Slot/gauze _____ Length _____
Set between 7 1/2 ft. and 65 ft.
Fittings: _____
Gravel pack Yes No Size range of material 1/4 to 5/8"

9 Static water level:
14 ft. below land surface Date 5-22-28

10 Pumping level below land surfaces:
60 ft. after 4 hrs. pumping 580 g.p.m.
_____ ft. after _____ hrs. pumping _____ g.p.m.
Estimated maximum yield 580 g.p.m.

11 Water sample submitted:
 Yes No Date _____

12 Well head completion:
 Pitless adapter Inches above grade

13 Well grouted? Yes No
 Neat cement Bentonite _____
Depth: From 0 ft. to 4 ft.

14 Nearest source of possible contamination:
ft. _____ Direction _____ Type _____
Well disinfected upon completion? Yes No

15 Pump: Not installed
Manufacturer's name Arlton
Model number _____ HP 20 Volts 220
Length of drop pipe _____ ft. capacity _____ g.m.p.
Type:
 Submersible Turbine
 Jet Reciprocating
 Centrifugal Other

16 Remarks: elevation

Topography:
 Hill
 Slope
 Upland
 Valley

17 Water well contractor's certification:
This well was drilled under my jurisdiction and this report is true to the best of my knowledge and belief.
RKL 303
Business name _____ License No. _____
Address Box 345 Hill City, Mo.
Signed Walter Jones Date 6-25-28
Authorized representative

5
13 W
20
NE W 5 W