USE TYPEWRITER OR BALL POINT PEN-PRESS FIRMLY, PRINT CLEARLY.

T R EW sec 1/4 1/4 1/4 No.

WATER WELL RECORD
KSA 82a-1201-1215

Kansas State Dept. Of Health
(Water Well Contractors)
Forbes-Bldg. 740
Topeka, Kansas 66620

1 Location of well:	County	Township name	Fraction	Section number	Town number	Range number
	SMITH		SW¼ NW¼ SE¼	21	T5S	R13W

Distance and direction from nearest town or city: Gaylord Kan.

Street address of well location if in city: 9E 3S 1/8 E 1/4 N

3 Owner of well: George Dollof

Address: Portis, Kansas

Locate with "X" in section below:

Sketch map:

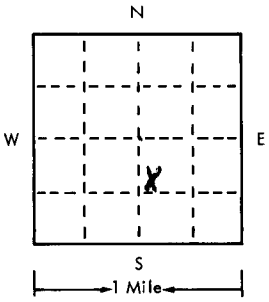

4 Well depth: 80 ft. Date of completion Aug-30-75
Well diameter 30 in.

5 ☐ Cable tool ☐ Rotary ☐ Driven ☐ Dug
☐ Hollow rod ☐ Jetted ☐ Bored ☒ Reverse rotary

6 Use: ☐ Domestic ☐ Public supply ☐ Industry
☒ Irrigation ☐ Air conditioning ☐ Commercial
☐ Test well ☐ ~~Cement Lubricator~~

7 Casing: Material Cement Height: above/below
Threaded ☐ Welded ☐ Surface 12 in.
Diam. 16" Weight 25 lbs. Pan E.T.
— in. to — ft. depth Drive shoe? ☐ Yes ☒ No
16 in. to 80 ft. depth

2

Type and color of material	From	To
Clay yellow	1	35
Sand yellow -	35	55
Blue Mud	55	60
Green Sand	60	78
Shale Blue	78	80
(use a second sheet if needed)		

8 Screen:
Manufacturer Johnsons
Type Cement pib. Dia. 16"
Slot/gauze 1/4" Length 38'
Set between 42 ft. and 80 ft.
Fittings:
Gravel pack ☒ Yes ☐ No Size range of material 1/4"

9 Static water level:
26 ft. below land surface Date July-12-75

10 Pumping level below land surfaces:
— ft. after — hrs. pumping — g.p.m.
— ft. after — hrs. pumping — g.p.m.
Estimated maximum yield 900 g.p.m.

11 Water sample submitted:
☐ Yes ☒ No Date

12 Well head completion:
☐ Pitless adapter ☐ Inches above grade

13 Well grouted? ☒ Yes ☐ No
☒ Neat cement ☐ Bentonite ☐
Depth: From 6 ft. to 16 ft.

14 Nearest source of possible contamination:
ft. 200' Direction North Type River
Well disinfected upon completion? ☐ Yes ☒ No

15 Pump: ☐ Not installed
Manufacturer's name Western Land Roller
Model number — HP — Volts —
Length of drop pipe 78 ft. capacity 1000 g.m.p.
Type:
☐ Submersible ☒ Turbine
☐ Jet ☐ Reciprocating
☐ Centrifugal ☐ Other

16 Remarks: elevation

Topography:
☐ Hill
☒ Slope
☐ Upland
☐ Valley

17 Water well contractor's certification:
This well was drilled under my jurisdiction and this report is true to the best of my knowledge and belief.
D & D Service 108
Business name License No.
Address Downs, Kansas
Signed Wendell Bibey Date Aug-30-75
Authorized representative

Forward the white, blue and pink copies to the Kansas State Dept. Of Health.

Form WWC-5