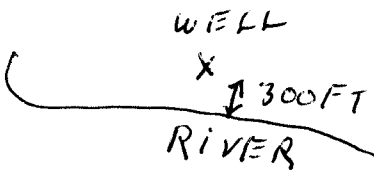


USE TYPEWRITER OR BALL POINT PEN-PRESS FIRMLY, PRINT CLEARLY.

WATER WELL RECORD
KSA 82a-1201-1215

Kansas Department of Health and Environment-Division of Environment (Water well Contractors) Topeka, Kansas 66620

1. Location of well:	County SMITH	Fraction SE 1/4 SE 1/4 SE 1/4	Section number 12	Township number T 5 S R 14 E (W)	Range number
2. Distance and direction from nearest town or city: Street address of well location if in city:	1 S OF Gaylord		3. Owner of well: LAWRENCE CONRAD R.R. or street: City, state, zip code: Gaylord Kan.		
4. Locate with "X" in section below: N W E S 1 Mile	Sketch map: 		6. Bore hole dia. 24 in. Completion date 4-12-77 Well depth 57 ft.		
5. Type and color of material			7. <input type="checkbox"/> Cable tool <input type="checkbox"/> Rotary <input type="checkbox"/> Driven <input type="checkbox"/> Dug <input type="checkbox"/> Hollow rod <input type="checkbox"/> Jetted <input type="checkbox"/> Bored <input checked="" type="checkbox"/> Reverse rotary		
			8. Use: <input type="checkbox"/> Domestic <input type="checkbox"/> Public supply <input type="checkbox"/> Industry <input checked="" type="checkbox"/> Irrigation <input type="checkbox"/> Air conditioning <input type="checkbox"/> Stock <input type="checkbox"/> Lawn <input type="checkbox"/> Oil field water <input type="checkbox"/> Other		
From To			9. Casing: Material ASB Height: Above or below Threaded <input type="checkbox"/> Welded <input type="checkbox"/> Surface 10 in. RMP <input type="checkbox"/> PVC <input type="checkbox"/> Weight _____ lbs./ft. Dia. 16 in. to 57 ft. depth Wall Thickness: inches or Dia. _____ in. to _____ ft. depth gage No. 12 "		
			10. Screen: Manufacturer's name JOHNSONS Type CASB Dia. 16" Sloy gauze 18 Length 13' Set between 45 ft. and 57 ft. _____ ft. and _____ ft. Gravel pack? <input checked="" type="checkbox"/> Size range of material 1/2"		
18. Elevation: Topography: <input type="checkbox"/> Hill <input type="checkbox"/> Slope <input type="checkbox"/> Upland <input checked="" type="checkbox"/> Valley			11. Static water level: _____ mo./day/yr. 30 ft. below land surface Date 4-10-77		
			12. Pumping level below land surfaces: 50 ft. after 2 hrs. pumping 1000 g.p.m. _____ ft. after _____ hrs. pumping _____ g.p.m. Estimated maximum yield 1200 g.p.m.		
19. Remarks:			13. Water sample submitted: _____ mo./day/yr. Yes <input type="checkbox"/> No <input checked="" type="checkbox"/> Date _____		
			14. Well head completion: <input type="checkbox"/> Pitless adapter _____ Inches above grade		
			15. Well grouted? YES With: <input type="checkbox"/> Neat cement <input type="checkbox"/> Bentonite <input checked="" type="checkbox"/> Concrete Depth: From 15 ft. to 5 ft.		
			16. Nearest source of possible contamination: ft. 300 Direction S Type RIVER Well disinfected upon completion? <input type="checkbox"/> Yes <input checked="" type="checkbox"/> No		
(Use a second sheet if needed)			17. Pump: _____ Not installed Manufacturer's name WESTERN LAWD Model number _____ HP _____ Volts _____ Length of drop pipe 55 ft. capacity 900 g.p.m. Type: <input type="checkbox"/> Submersible <input checked="" type="checkbox"/> Turbine <input type="checkbox"/> Jet <input type="checkbox"/> Reciprocating <input type="checkbox"/> Centrifugal <input type="checkbox"/> Other		
			20. Water well contractor's certification: This well was drilled under my jurisdiction and this report is true to the best of my knowledge and belief. D & D Service 108 Business name Downs Kan. License No. _____ Address _____ Signed Wendell DeBee Date 4-18-77 Authorized representative		

-5-17-77
R
1/4 SE SE SE
1/4 SE SE SE
1/4