


1 LOCATION OF WATER WELL: County: SMITH	Fraction SE 1/4 NE NE 1/4 NE 1/4	Section Number 19	Township Number T 5 S	Range Number R 15 E/W
--	--	----------------------	--------------------------	--------------------------

Distance and direction from nearest town or city street address of well if located within city?
4 miles South of CLAUDELL KS and 1 miles West

2 WATER WELL OWNER: LIMESTONE FARMS
RR#, St. Address, Box #: C/O Weltmer Law Office PO BOX 303 Board of Agriculture, Division of Water Resources
City, State, ZIP Code: Mankato KS 66956 Application Number:

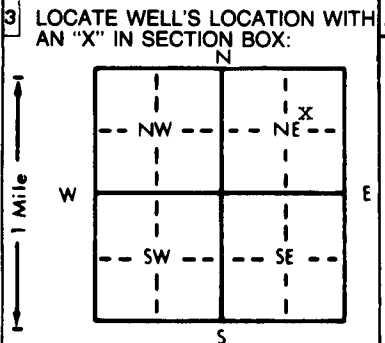

4 DEPTH OF COMPLETED WELL: 52 ft. ELEVATION:
Depth(s) Groundwater Encountered 1. 25 ft. 2. ft. 3. ft.
WELL'S STATIC WATER LEVEL: 25 ft. below land surface measured on mo/day/yr 9-15-98
Pump test data: Well water was ft. after hours pumping gpm
Est. Yield: 50 gpm; Well water was ft. after hours pumping gpm
Bore Hole Diameter: 10 in. to 52 ft., and in. to ft.
WELL WATER TO BE USED AS:
5 Public water supply 8 Air conditioning 11 Injection well
XX Domestic 3 Feedlot 6 Oil field water supply 9 Dewatering 12 Other (Specify below)
2 Irrigation 4 Industrial 7 Lawn and garden only 10 Monitoring well
Was a chemical/bacteriological sample submitted to Department? Yes.....No...XX...; If yes, mo/day/yr sample was submitted
Water Well Disinfected? Yes No XX

5 TYPE OF BLANK CASING USED:
1 Steel 3 RMP (SR) 5 Wrought iron 8 Concrete tile CASING JOINTS: Glued .XX. Clamped
XX PVC 4 ABS 6 Asbestos-Cement 9 Other (specify below) Welded
7 Fiberglass Threaded
Blank casing diameter: 5 in. to 32 ft., Dia. in. to ft., Dia. in. to ft.
Casing height above land surface: 18 in., weight 160 lbs./ft. Wall thickness or gauge No.
TYPE OF SCREEN OR PERFORATION MATERIAL:
1 Steel 3 Stainless steel 5 Fiberglass 8 RMP (SR) 10 Asbestos-cement
2 Brass 4 Galvanized steel 6 Concrete tile 9 ABS 11 Other (specify)
12 None used (open hole)
SCREEN OR PERFORATION OPENINGS ARE:
1 Continuous slot XX Mill slot 5 Gauzed wrapped 8 Saw cut 11 None (open hole)
2 Louvered shutter 4 Key punched 6 Wire wrapped 9 Drilled holes
7 Torch cut 10 Other (specify)
SCREEN-PERFORATED INTERVALS: From 32 ft. to 52 ft., From ft. to ft.
GRAVEL PACK INTERVALS: From 30 ft. to 52 ft., From ft. to ft.
From ft. to ft., From ft. to ft.

6 GROUT MATERIAL: 1 Neat cement 2 Cement grout XX Bentonite 4 Other
Grout Intervals: From 0 ft. to 30 ft., From ft. to ft., From ft. to ft.
What is the nearest source of possible contamination:
1 Septic tank 4 Lateral lines 7 Pit privy 10 Livestock pens 14 Abandoned water well
2 Sewer lines 5 Cess pool 8 Sewage lagoon 11 Fuel storage 15 Oil well/Gas well
3 Watertight sewer lines 6 Seepage pit 9 Feedyard 12 Fertilizer storage 16 Other (specify below)
13 Insecticide storage

Direction from well? How many feet?

FROM	TO	LITHOLOGIC LOG	FROM	TO	PLUGGING INTERVALS
0	12	SURFACE CLAY			
12	30	ROCK & MED SAND			
30	45	SOFT WHITE CLAY			
45	52	BLUE SHALE			

7 CONTRACTOR'S OR LANDOWNER'S CERTIFICATION: This water well was ~~re~~ constructed, (2) reconstructed, or (3) plugged under my jurisdiction and was completed on (mo/day/year) 9-15-98 and this record is true to the best of my knowledge and belief. Kansas Water Well Contractor's License No. 444 This Water Well Record was completed on (mo/day/year) 9-15-98 under the business name of ANDY ANDERSON DRILLING by (signature) Andy Anderson

OFFICE USE ONLY T R E W SEC. 1/4 1/4 1/4