USE TYPEWRITER OR BALL POINT PEN-PRESS FIRMLY, PRINT CLEARLY.

T R EW sec 1/4 1/4 1/4 No.

WATER WELL RECORD
KSA 82a-1201-1215

Kansas State Dept. Of Health
(Water Well Contractors)
Forbes-Bldg. 740
Topeka, Kansas 66620

1 Location of well:	County	Township name	Fraction	Section number	Town number	Range number
	Smith	Dor	W½+N½NE¼	10	5	15

Distance and direction from nearest town or city: 7 Miles SW
Street address of well location if in city: Cedar, KS

3 Owner of well: Daniel T. Newbrey
Address: Cedar, Kansas

Locate with "X" in section below:

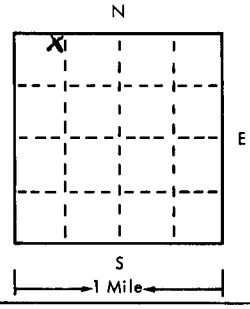

Sketch map:

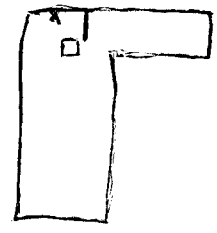

4 Well depth: 60' ft. Date of completion 12-20-75
Well diameter 9 in.

5 ☐ Cable tool ☒ Rotary ☐ Driven ☐ Dug
☐ Hollow rod ☐ Jetted ☐ Bored ☐ Reverse rotary

6 Use: ☒ Domestic ☐ Public supply ☐ Industry
☐ Irrigation ☐ Air conditioning ☐ Commercial
☐ Test well ☐

7 Casing: Material PVC Height: above/below
Threaded ☐ Welded ☒ Surface 18 in.
Diam. 5" in. to 60' ft. depth Weight ___ lbs./ft.
___ in. to ___ ft. depth Drive shoe? ☐ Yes ☒ No

2

Type and color of material	From	To
Black Dirt	0'	30'
Yellow Clay	30	50
Coarse Gravel	50	60
Blue Shale	60	

(use a second sheet if needed)

8 Screen:
Manufacturer Jesse Lowell
Type PVC Dia. 5"
Slot/gauze 40" Length 10'
Set between 50 ft. and 60 ft.
Fittings:
Gravel pack ☒ Yes ☐ No Size range of material 40

9 Static water level:
40 ft. below land surface Date 12-20-75

10 Pumping level below land surfaces:
50 ft. after 4 hrs. pumping 30 g.p.m.
___ ft. after ___ hrs. pumping ___ g.p.m.
Estimated maximum yield ___ g.p.m.

11 Water sample submitted:
☐ Yes ☒ No Date ___

12 Well head completion:
☒ Pitless adapter ☐ Inches above grade

13 Well grouted? ☒ Yes ☐ No
☒ Neat cement ☐ Bentonite ☐
Depth: From 30 ft. to 5 ft.

14 Nearest source of possible contamination:
ft. 1000' Direction South Type Feedlot
Well disinfected upon completion? ☒ Yes ☐ No

15 Pump: ☐ Not installed
Manufacturer's name Fairbanks Morse
Model number ___ HP 3/4 Volts 220
Length of drop pipe 50 ft. capacity 30 g.m.p.
Type:
☒ Submersible ☐ Turbine
☐ Jet ☐ Reciprocating
☐ Certrifugal ☐ Other

16 Remarks: elevation

Topography:
☐ Hill
☐ Slope
☐ Upland
☒ Valley

17 Water well contractor's certification:
This well was drilled under my jurisdiction and this report is true to the best of my knowledge and belief.
P+J Well Drilling 269 B
Business name License No.
Address Bazy
Signed Paul [illegible] Date 1-20-76
Authorized representative

5 15W 10 NE

Forward the white, blue and pink copies to the Kansas State Dept. Of Health.

Form WWC-5