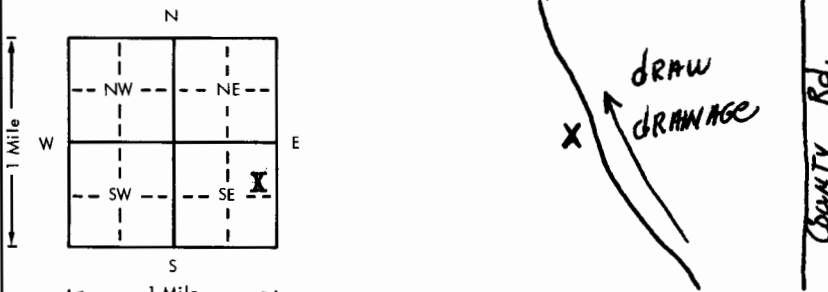


USE TYPEWRITER OR BALL
POINT PEN-PRESS FIRMLY,
PRINT CLEARLY.

WATER WELL RECORD
KSA 82a-1201-1215

Kansas Department of Health and
Environment-Division of Environment
(Water well Contractors)
Topeka, Kansas 66620

1. Location of well:		County Phillips	Fraction SE 1/4 NE 1/4 SE 1/4	Section number 2	Township number T 5 S R 19	Range number 19
2. Distance and direction from nearest town or city: From Speed, 2 mi. south on west side of Rd.			3. Owner of well: Dr. Tom Krauss R.R. or street: Rt. 4 City, state, zip code: Phillipsburg, Ks. 67661			
4. Locate with "X" in section below: 			6. Bore hole dia. 9 1/2 in. Completion date 4-29-78 Well depth 42 ft.			
5. Type and color of material			7. <input checked="" type="checkbox"/> Cable tool <input type="checkbox"/> Rotary <input type="checkbox"/> Driven <input type="checkbox"/> Dug <input type="checkbox"/> Hollow rod <input type="checkbox"/> Jetted <input type="checkbox"/> Bored <input type="checkbox"/> Reverse rotary			
Top Soil			8. Use: <input type="checkbox"/> Domestic <input type="checkbox"/> Public supply <input type="checkbox"/> Industry <input type="checkbox"/> Irrigation <input type="checkbox"/> Air conditioning <input checked="" type="checkbox"/> Stock <input type="checkbox"/> Lawn <input type="checkbox"/> Oil field water <input type="checkbox"/> Other			
Lt. Yellow Clay			9. Casing: Material Plastic Weight: Above or below Threaded <input type="checkbox"/> Welded <input type="checkbox"/> Surface 2 1/2 in. RMP <input type="checkbox"/> PVC <input checked="" type="checkbox"/> Weight <input type="checkbox"/> lbs./ft. Dia. 6 in. to 42 ft. depth Wall Thickness: inches or Dia. <input type="checkbox"/> in. to <input type="checkbox"/> ft. depth gage No. Sch. 200			
Fine Sand & Silt			10. Screen: Manufacturer's name Western Type <input type="checkbox"/> Dia. 6 in. Slot/gauze 1/8 in. Length 15 ft. Set between 42 ft. and 27 ft. ft. and <input type="checkbox"/> ft. Gravel pack? Yes Size range of material 1/2 in. minus			
Med. Sand			11. Static water level: <input type="checkbox"/> mo./day/yr. 23 ft. below land surface Date 4-29-78			
Coarse Gravel			12. Pumping level below land surfaces: <input type="checkbox"/> ft. after <input type="checkbox"/> hrs. pumping <input type="checkbox"/> g.p.m. <input type="checkbox"/> ft. after <input type="checkbox"/> hrs. pumping <input type="checkbox"/> g.p.m. Estimated maximum yield 9 g.p.m.			
Fossil Rocks & Sandstone			13. Water sample submitted: <input type="checkbox"/> Yes <input checked="" type="checkbox"/> No Date <input type="checkbox"/>			
Shale			14. Well head completion: <input type="checkbox"/> Pitless adapter 2 1/2 inches above grade			
NOT in Og			15. Well grouted? Yes With: <input type="checkbox"/> Neat cement <input checked="" type="checkbox"/> Bentonite <input type="checkbox"/> Concrete Depth: From 0 ft. to 17 ft.			
40'			16. Nearest source of possible contamination: None ft. <input type="checkbox"/> Direction <input type="checkbox"/> Type <input type="checkbox"/> Well disinfected upon completion? <input type="checkbox"/> Yes <input checked="" type="checkbox"/> No			
17 1/2' sat thick			17. Pump: <input checked="" type="checkbox"/> Not installed Manufacturer's name <input type="checkbox"/> Model number <input type="checkbox"/> HP <input type="checkbox"/> Volts <input type="checkbox"/> Length of drop pipe <input type="checkbox"/> ft. capacity <input type="checkbox"/> g.p.m. Type: <input type="checkbox"/> Submersible <input type="checkbox"/> Turbine <input type="checkbox"/> Jet <input type="checkbox"/> Reciprocating <input type="checkbox"/> Centrifugal <input type="checkbox"/> Other			
15 40'			20. Water well contractor's certification: This well was drilled under my jurisdiction and this report is true to the best of my knowledge and belief. Deer Drilling 3/1/4 Business name License No. Address Rt. 4 Phillipsburg, Ks. Signed William J. Deer Date 4-29-78 Authorized representative			
18. Elevation:			19. Remarks: Customer will install concrete slab around casing			
Topography: <input type="checkbox"/> Hill <input type="checkbox"/> Slope <input type="checkbox"/> Upland <input checked="" type="checkbox"/> Valley						