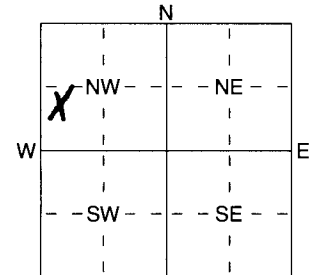


1 LOCATION OF WATER WELL: Fraction NW 1/4 SW 1/4 NW 1/4 Section Number 31 Township Number T 5 S Range Number R 2 ~~10~~

Distance and direction from nearest town or city street address of well if located within city? From Clay until 60 East 2 miles on 7 Hwy to 180th St. + Go South 1/2 mile

2 WATER WELL OWNER: ENIV Wilford RR#, St. Address, Box #: 1818 North 180th City, State, ZIP Code: Concordia, KS 66901 Board of Agriculture, Division of Water Resources Application Number:

3 LOCATE WELL'S LOCATION WITH AN "X" IN SECTION BOX:  4 DEPTH OF COMPLETED WELL 58.1 ft. ELEVATION: Depth(s) Groundwater Encountered 1 4.1 ft. 2 WELL'S STATIC WATER LEVEL 35 ft. below land surface measured on mo/day/yr Pump test data: Well water was Est. Yield 16 gpm: Well water was WELL WATER TO BE USED AS: 1 Domestic 3 Feedlot 6 Oil field water supply 9 Dewatering 12 Other (Specify below) 2 Irrigation 4 Industrial 7 Domestic (lawn & garden) 10 Monitoring well Was a chemical/bacteriological sample submitted to Department? Yes No If yes, mo/day/yrs sample was submitted Water Well Disinfected? Yes No

5 TYPE OF BLANK CASING USED: 1 Steel 2 PVC 3 RMP (SR) 4 ABS 5 Wrought iron 6 Asbestos-Cement 7 Fiberglass 8 Concrete tile 9 Other (specify below) CASING JOINTS: Glued Welded Clamped Threaded Blank casing diameter 5 in. to 3.8 ft. Dia Casing height above land surface 21 in., weight 54.40 lbs./ft. Wall thickness or gauge No. TYPE OF SCREEN OR PERFORATION MATERIAL: 1 Steel 2 Brass 3 Stainless Steel 4 Galvanized Steel 5 Fiberglass 6 Concrete tile 7 PVC 8 RMP (SR) 9 ABS 10 Asbestos-Cement 11 Other (Specify) 12 None used (open hole) SCREEN OR PERFORATION OPENINGS ARE: 1 Continuous slot 2 Louvered shutter 3 Mill slot 4 Key punched 5 Gauzed wrapped 6 Wire wrapped 7 Torch cut 8 Saw cut 9 Drilled holes 10 Other (specify) 11 None (open hole) SCREEN-PERFORATED INTERVALS: From 3.8 ft. to 5.8 ft. GRAVEL PACK INTERVALS: From 2.5 ft. to 5.8 ft.

6 GROUT MATERIAL: 1 Neat cement 2 Cement grout 3 Bentonite 4 Other Grout Intervals: From 3 ft. to 2.5 ft. What is the nearest source of possible contamination: 1 Septic tank 2 Sewer lines 3 Watertight sewer lines 4 Lateral lines 5 Cess pool 6 Seepage pit 7 Pit privy 8 Sewage lagoon 9 Feedyard 10 Livestock pens 11 Fuel storage 12 Fertilizer storage 13 Insecticide storage 14 Abandoned water well 15 Oil well/Gas well 16 Other (specify below) Direction from well? South How many feet? 100

FROM	TO	LITHOLOGIC LOG	FROM	TO	PLUGGING INTERVALS
0	1	Top Soil			
1	41	Brown Clay			
41	44	Fine Sand			
44	49	Medium Sand (Water)			
49	58	Reddish Shell			

7 CONTRACTOR'S OR LANDOWNER'S CERTIFICATION: This water well was (1) constructed, (2) reconstructed, or (3) plugged under my jurisdiction and was completed on (mo/day/year) 11/4/2002 and this record is true to the best of my knowledge and belief. Kansas Water Well Contractor's Licence No 457 This Water Well Record was completed on (mo/day/yr) 12/3/2002 under the business name of Holdeman Well Drilling by (signature) Craig C. W. D. S.