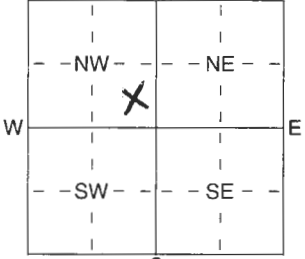


1 LOCATION OF WATER WELL: County: Cloud	Fraction SE 1/4 SE 1/4 NW 1/4	Section Number 32	Township Number T 5 S	Range Number R 2 W
---	---	-----------------------------	---------------------------------	-------------------------------------

Distance and direction from nearest town or city street address of well if located within city?
4 miles East of Concordia, Ks. 1923 Rust Rd.

2 WATER WELL OWNER: **Eugene McDaniel**
 RR#, St. Address, Box # : **1951 Rust Rd.**
 City, State, ZIP Code : **Concordia, Ks. 66901**
 Board of Agriculture, Division of Water Resources
 Application Number:

3 LOCATE WELL'S LOCATION WITH AN "X" IN SECTION BOX:


4 DEPTH OF COMPLETED WELL **46** ft. ELEVATION: ft.
 Depth(s) Groundwater Encountered 1 ft. 2 ft. 3 ft.
 WELL'S STATIC WATER LEVEL **34** ft. below land surface measured on mo/day/yr **9/30/04**
 Pump test data: Well water was ft. after hours pumping gpm
 Est. Yield **15-20** gpm: Well water was ft. after hours pumping gpm
 WELL WATER TO BE USED AS:
 Domestic 3 Feedlot 6 Oil field water supply 9 Dewatering 12 Other (Specify below)
 2 Irrigation 4 Industrial 7 Domestic (lawn & garden) 10 Monitoring well

Was a chemical/bacteriological sample submitted to Department? Yes No ; If yes, mo/day/yr sample was submitted
 Water Well Disinfected? Yes No

5 TYPE OF BLANK CASING USED:
 1 Steel 3 RMP (SR) 5 Wrought iron 8 Concrete tile CASING JOINTS: Glued Clamped
 PVC 4 ABS 6 Asbestos-Cement 9 Other (specify below) Welded
 7 Fiberglass Threaded

Blank casing diameter **5** in. to **36** ft., Dia in. to ft., Dia in. to ft.
 Casing height above land surface **12** in., weight **2.37** lbs./ft. Wall thickness or gauge No. **0.214**

TYPE OF SCREEN OR PERFORATION MATERIAL:
 PVC 10 Asbestos-Cement
 1 Steel 3 Stainless Steel 5 Fiberglass 8 RMP (SR) 11 Other (Specify)
 2 Brass 4 Galvanized Steel 6 Concrete tile 9 ABS 12 None used (open hole)

SCREEN OR PERFORATION OPENINGS ARE:
 1 Continuous slot Mill slot 5 Gauzed wrapped 8 Saw cut 11 None (open hole)
 2 Louvered shutter 4 Key punched 6 Wire wrapped 9 Drilled holes
 7 Torch cut 10 Other (specify) ft.

SCREEN-PERFORATED INTERVALS: From **36** ft. to **46** ft., From ft. to ft.
 From ft. to ft., From ft. to ft.
 GRAVEL PACK INTERVALS: From **20** ft. to **46** ft., From ft. to ft.
 From ft. to ft., From ft. to ft.

6 GROUT MATERIAL: 1 Neat cement 2 Cement grout Bentonite 4 Other

Grout Intervals: From **0** ft. to **20** ft., From ft. to ft., From ft. to ft.

What is the nearest source of possible contamination:
 1 Septic tank 4 Lateral lines 7 Pit privy 10 Livestock pens 14 Abandoned water well
 2 Sewer lines 5 Cess pool 8 Sewage lagoon 11 Fuel storage 15 Oil well/Gas well
 3 Watertight sewer lines 6 Seepage pit 9 Feedyard 12 Fertilizer storage Other (specify below) **creek**
 13 Insecticide storage

Direction from well? **West** How many feet? **100 ft**

FROM	TO	LITHOLOGIC LOG	FROM	TO	PLUGGING INTERVALS
0	3	Topsoil, sandy			
3	28	Clay, sandy/tan			
28	32	Sand, fine			
32	48	Sand, medium			
48	49	Clay, tan			

RECEIVED
OCT 11 2004
BUREAU OF WATER

7 CONTRACTOR'S OR LANDOWNER'S CERTIFICATION: This water well was (1) constructed, (2) reconstructed, or (3) plugged under my jurisdiction and was completed on (mo/day/year) **9/30/04** and this record is true to the best of my knowledge and belief. Kansas Water Well Contractor's Licence No **138**. This Water Well Record was completed on (mo/day/yr) **10/5/04** under the business name of **Peterson Irrigation, Inc.** by (signature) *Mike Peterson*