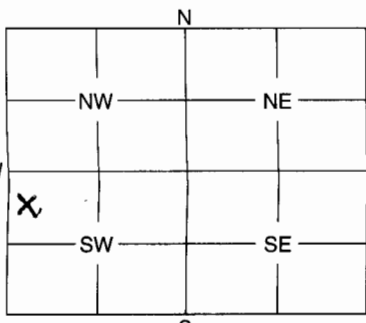


1 LOCATION OF WATER WELL:	Fraction	Section Number	Township Number	Range	Number
County: CLOUD	SW 1/4 1/4 1/4	4	5	3	E/W

Distance and direction from nearest town or city street address of well if located within city?

4 Miles N of Concordia, 1/2 mile West, 3/8 mile North

2 WATER WELL OWNER:	James L. Sjogren	
RR #, St. Address, Box #:	1346 Wagon Rd.	
City, State, ZIP Code :	Concordia, Kansas	66901
	Board of Agriculture, Division of Water Resources Application Number:	

3 MARK WELL'S LOCATION WITH AN "X" IN SECTION BOX: 	4 DEPTH OF WELL 71 ft. WELL'S STATIC WATER LEVEL... 50 ft. WELL WAS USED AS: <table style="width:100%;"> <tr> <td><input checked="" type="radio"/> 1 Domestic</td> <td>5 Public Water Supply</td> <td>9 Dewatering</td> </tr> <tr> <td>2 Irrigation</td> <td>6 Oil Field Water Supply</td> <td>10 Monitoring Well</td> </tr> <tr> <td>3 Feedlot</td> <td>7 Domestic (Lawn & Garden)</td> <td>11 Injection Well</td> </tr> <tr> <td>4 Industrial</td> <td>8 Air Conditioning</td> <td>12 Other</td> </tr> </table> <p>Was a chemical / bacteriological sample submitted to Department? Yes No</p> <p>If yes, mo/day/yr sample was submitted</p> <p>Water Well Disinfected: Yes <input checked="" type="checkbox"/> No</p>	<input checked="" type="radio"/> 1 Domestic	5 Public Water Supply	9 Dewatering	2 Irrigation	6 Oil Field Water Supply	10 Monitoring Well	3 Feedlot	7 Domestic (Lawn & Garden)	11 Injection Well	

5 TYPE OF BLANK CASING USED:	1 Steel 3 RMP (SR) 5 Wrought 7 Fiberglass 9 Other (Specify below) Handdug	
	2 PVC 4 ABS 6 Asbestos-Cement 8 Concrete Tile	
	Blank casing diameter in. Was casing pulled? Yes No .X If yes, how much	
	Casing height above or below land surface in.	

6 GROUT PLUG MATERIAL:	1 Neat cement	2 Cement grout	3 Bentonite	4 Other
Grout Plug Intervals:	From ft. to	From ft. to	From ft. to	From to
What is the nearest source of possible contamination:				
1 Septic tank	6 Seepage pit	11 Fuel storage	16 Other (specify below)	
2 Sewer lines	7 Pit privy	12 Fertilizer storage	
3 Watertight sewer lines	8 Sewage lagoon	13 Insecticide storage	
4 Lateral lines	9 Feedyard	14 Abandoned water well	
5 Cess pool	10 Livestock pens	15 Oil well/Gas well	
Direction from well?		How many feet?		

FROM	TO	PLUGGING MATERIALS
0	4	Top Soil
4.0	4.5	Plug
4.5	50	Subsoil
50	71	Sand

7 CONTRACTOR'S OF LANDOWNER'S CERTIFICATION:	This water well was plugged under my jurisdiction and was completed on (mo/day/year) 09/11/06 and this record is true to the best of my knowledge and belief. Kansas Water Well Contractor's License No. This Water Well Record was completed on (mo/day/year) under the business name of by (signature) James L. Sjogren	
--	--	--

INSTRUCTIONS: Use typewriter or ball point pen. Please press firmly and print clearly. Please fill in blanks, underline or circle the correct answers. Send top three copies to Kansas Department of Health and Environment, Bureau of Water, Geology Section, 1000 SW Jackson St., Ste. 420, Topeka, Kansas 66612-1367. Telephone: 785/296-5522. Send one to Water Well Owner and retain one for your records.