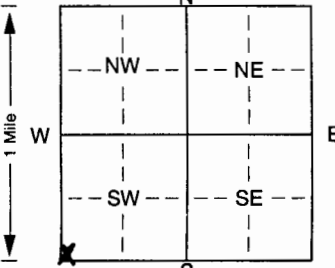


1 LOCATION OF WATER WELL: Fraction SW 1/4 SW 1/4 SW 1/4 Section Number 31 Township Number T 5 S Range Number R 2 E W
 County: Cloud

Distance and direction from nearest town or city street address of well if located within city?
2 miles east of Concordia on Hwy 9; 1/2 mile South

2 WATER WELL OWNER: Kevin Wiedel
 RR#, St. Address, Box #: 1349 Rd 6200 Board of Agriculture, Division of Water Resources
 City, State, ZIP Code: Hebron NE 68370 Application Number:

3 LOCATE WELL'S LOCATION WITH AN "X" IN SECTION BOX:  4 DEPTH OF COMPLETED WELL: 180 ft. ELEVATION: ft.
 Depth(s) Groundwater Encountered ft. 2. ft. 3. ft.
 WELL'S STATIC WATER LEVEL: 48 ft. below land surface measured on mo/day/yr 10/24/07
 Pump test data: Well water was ft. after hours pumping gpm
 Est. Yield 10 gpm: Well water was ft. after hours pumping gpm
 Bore Hole Diameter: 10 in. to 180 ft., and in. to ft.
 WELL WATER TO BE USED AS: 5 Public water supply 8 Air conditioning 11 Injection well
 1 Domestic 3 Feedlot 6 Oil field water supply 9 Dewatering 12 Other (Specify below)
 2 Irrigation 4 Industrial 7 Domestic (lawn & garden) 10 Monitoring well Stack Well
 Was a chemical/bacteriological sample submitted to Department? Yes. No. X; If yes, mo/day/yr sample was submitted
 Water Well Disinfected? Yes No

5 TYPE OF BLANK CASING USED: 5 Wrought iron 8 Concrete tile CASING JOINTS: Glued X Clamped
 1 Steel 3 RMP (SR) 6 Asbestos-Cement 9 Other (specify below) Welded
2 PVC 4 ABS 7 Fiberglass Threaded
 Blank casing diameter: 5 in. to 120 ft., Dia in. to ft., Dia in. to ft.
 Casing height above land surface: 18 in., weight 2.893 lbs./ft. Wall thickness or gauge No. 265
 TYPE OF SCREEN OR PERFORATION MATERIAL: 7 PVC 10 Asbestos-cement
 1 Steel 3 Stainless steel 5 Fiberglass 8 RMP (SR) 11 Other (specify)
 2 Brass 4 Galvanized steel 6 Concrete tile 9 ABS 12 None used (open hole)
 SCREEN OR PERFORATION OPENINGS ARE: 5 Gauzed wrapped 8 Saw cut 11 None (open hole)
 1 Continuous slot 3 Mill slot 6 Wire wrapped 9 Drilled holes
 2 Louvered shutter 4 Key punched 7 Torch cut 10 Other (specify) ft.
 SCREEN-PERFORATED INTERVALS: From: 120 ft. to 180 ft., From ft. to ft.
 From: ft. to ft., From ft. to ft.
 GRAVEL PACK INTERVALS: From: 15 ft. to 180 ft., From ft. to ft.
 From: ft. to ft., From ft. to ft.

6 GROUT MATERIAL: 1 Neat cement 2 Cement grout 3 Bentonite 4 Other
 Grout Intervals: From: 0 ft. to 15 ft., From ft. to ft., From ft. to ft.
 What is the nearest source of possible contamination:
 1 Septic tank 4 Lateral lines 7 Pit privy 10 Livestock pens 14 Abandoned water well
 2 Sewer lines 5 Cess pool 8 Sewage lagoon 11 Fuel storage 15 Oil well/Gas well
 3 Watertight sewer lines 6 Seepage pit 9 Feedyard 12 Fertilizer storage 16 Other (specify below)
 13 Insecticide storage
 Direction from well? How many feet?

FROM	TO	LITHOLOGIC LOG	FROM	TO	PLUGGING INTERVALS
0	5	Top Soil			
5	25	Brown & Tan Clay			
25	30	Tan Clay			
30	33	Tan & Gray Clay			
33	34	Orange Sand Stone			
34	35	Tan & Yellow Clay			
35	50	Tan-Gray-Orange Clay-mix			
50	55	Dark Gray Clay			
55	100	Red & White Fire Clay			
100	135	Hard Gray Clay - Mix Sand Stone			
135	137	Hard Sand Stone			
137	160	Hard Gray Clay			
160	178	Hard Red Fire Clay			
178	180	Sand Stone - Hard			

7 CONTRACTOR'S OR LANDOWNER'S CERTIFICATION: This water well was (1) constructed, (2) reconstructed, or (3) plugged under my jurisdiction and was completed on (mo/day/year) 10-24-07 and this record is true to the best of my knowledge and belief. Kansas Water Well Contractor's Licence No. 480 This Water Well Record was completed on (mo/day/yr) 11-12-07 under the business name of Williams Drilling Co Inc by (signature) Rm Williams