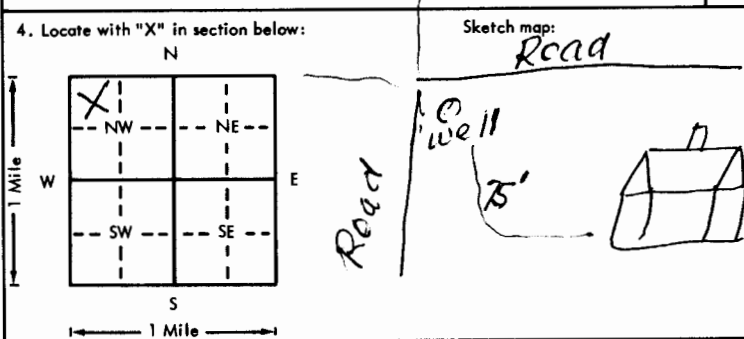


USE TYPEWRITER OR BALL POINT PEN—PRESS FIRMLY, PRINT CLEARLY.

WATER WELL RECORD
KSA 82a-1201-1215

Kansas Department of Health and Environment—Division of Environment (Water well Contractors)
Topeka, Kansas 66620

1. Location of well:	County <u>Cloud</u>	Fraction <u>NW 1/4 NW 1/4 NW 1/4</u>	Section number <u>17</u>	Township number T <u>5</u> S	Range number R <u>2</u> E/W
2. Distance and direction from nearest town or city: Street address of well location if in city:			3. Owner of well: <u>CLAIR MUNGER</u> R.R. or street: <u>Rfd 2 -</u> City, state, zip code: <u>Concordia Ks 66901</u>		
4. Locate with "X" in section below: 			6. Bore hole dia. <u>8</u> in. Completion date <u>Aug. 8, 1975</u> Well depth <u>93</u> ft.		
5. Type and color of material			7. <input checked="" type="checkbox"/> Cable tool <input checked="" type="checkbox"/> Rotary <input type="checkbox"/> Driven <input type="checkbox"/> Dug <input type="checkbox"/> Hollow rod <input type="checkbox"/> Jetted <input type="checkbox"/> Bored <input type="checkbox"/> Reverse rotary		
			8. Use: <input checked="" type="checkbox"/> Domestic <input type="checkbox"/> Public supply <input type="checkbox"/> Industry <input type="checkbox"/> Irrigation <input type="checkbox"/> Air conditioning <input type="checkbox"/> Stock <input type="checkbox"/> Lawn <input type="checkbox"/> Oil field water <input type="checkbox"/> Other		
From To			9. Casing: Material <u>PLASTIC</u> Height: Above or below Threading <input type="checkbox"/> Welded <input type="checkbox"/> Surface <u>12</u> in. RMP <input type="checkbox"/> PVC <input checked="" type="checkbox"/> Weight <u>1</u> lbs./ft. Dia. <u>5</u> in. to <u>93</u> ft. depth Wall Thickness: <u>inches</u> or Dia. <u>in.</u> to <u>ft.</u> depth gage No. <u>1/4</u>		
			10. Screens: Manufacturer's name <u>Western PLASTIC</u> Type <u>T 209</u> Dia. <u>5"</u> Slot/gauze <u>1/64</u> Length <u>20 ft</u> Set between <u>73</u> ft. and <u>93</u> ft. ft. and <u>ft.</u> Gravel pack? <input checked="" type="checkbox"/> Size range of material <u>1/4"</u>		
Black loam			11. Static water level: <u>60</u> ft. below land surface Date <u>Aug 10, 1975</u> mo./day/yr.		
Yellow shale			12. Pumping level below land surfaces: <u>80</u> ft. after <u>2</u> hrs. pumping <u>10</u> g.p.m. <u>ft.</u> after <u>hrs.</u> pumping <u>g.p.m.</u> Estimated maximum yield <u>g.p.m.</u>		
Clay			13. Water sample submitted: <input checked="" type="checkbox"/> Yes <input type="checkbox"/> No Date <u>Aug. 15 1975</u> mo./day/yr.		
SAND ROCK			14. Well head completion: <input checked="" type="checkbox"/> Pitless adapter <u>12"</u> inches above grade		
			15. Well grouted? <u>yes</u> With: <input type="checkbox"/> Neat cement <input type="checkbox"/> Bentonite <input checked="" type="checkbox"/> Concrete Depth: From <u>1</u> ft. to <u>10</u> ft.		
			16. Nearest source of possible contamination <u>cesspool</u> ft. <u>300</u> Direction <u>SW</u> Type <u>cesspool</u> Well disinfected upon completion? <input checked="" type="checkbox"/> Yes <input type="checkbox"/> No		
			17. Pump: <input type="checkbox"/> Not installed Manufacturer's name <u>Muets</u> Model number <u>S3952A</u> HP <u>1/2</u> Volts <u>220</u> Length of drop pipe <u>ft.</u> capacity <u>g.p.m.</u> Type: <input checked="" type="checkbox"/> Submersible <input type="checkbox"/> Turbine <input type="checkbox"/> Jet <input type="checkbox"/> Reciprocating <input type="checkbox"/> Centrifugal <input type="checkbox"/> Other		
(Use a second sheet if needed)					
18. Elevation: <u>1420ft</u>	19. Remarks:		20. Water well contractor's certification: This well was drilled under my jurisdiction and this report is true to the best of my knowledge and belief. <u>CARL THOMAN, JR.</u> 247 Business name <u>16th</u> License No. <u>383 E 16th Concordia Ks</u> Address <u>383 E 16th</u> Signed <u>Carl Thoman</u> Date <u>5/16/76</u> Authorized representative		

T 5
 R 2
 W 17
 Sec 17 NW
 1/4 1/4 1/4

Forward the white, blue and pink copies to the Department of Health and Environment

Form WWC45