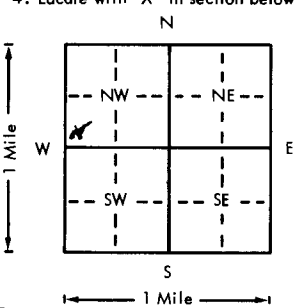
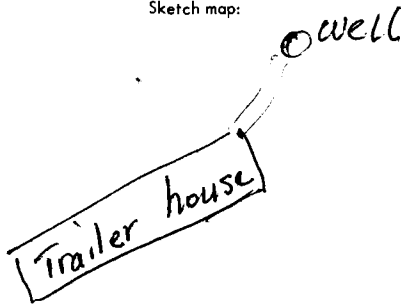


USE TYPEWRITER OR BALL POINT PEN-PRESS FIRMLY, PRINT CLEARLY.

WATER WELL RECORD
KSA 82a-1201-1215

Kansas Department of Health and Environment-Division of Environment (Water well Contractors)
Topeka, Kansas 66620

1. Location of well:	County <u>Cloud</u>	Fraction <u>Sub 1/4 SW 1/4 NW 1/4</u>	Section number <u>32</u>	Township number <u>T 5 S</u>	Range number <u>R 2 E</u>
2. Distance and direction from nearest town or city: <u>5 m East of Concordia</u>		3. Owner of well: <u>Robert de Duc</u> R.R. or street: <u>RFD 3</u> City, state, zip code: <u>Concordia, KS 66901</u>			
4. Locate with "X" in section below: 			Sketch map: 		
5. Type and color of material			From	To	
<u>Black soil</u>			<u>0</u>	<u>18</u>	
<u>Grey clay</u>			<u>19</u>	<u>31</u>	
<u>fine sand</u>			<u>32</u>	<u>34</u>	
<u>Course Gravel</u>			<u>35</u>	<u>50</u>	
<u>Red clay</u>			<u>51</u>	<u>53</u>	
(Use a second sheet if needed)					
6. Bore hole dia. <u>5</u> in. Completion date <u>6/15/77</u> Well depth <u>53</u> ft.	7. <input checked="" type="checkbox"/> Cable tool <input checked="" type="checkbox"/> Rotary <input type="checkbox"/> Driven <input type="checkbox"/> Dug <input type="checkbox"/> Hollow rod <input type="checkbox"/> Jetted <input type="checkbox"/> Bored <input type="checkbox"/> Reverse rotary				
8. Use: <input checked="" type="checkbox"/> Domestic <input type="checkbox"/> Public supply <input type="checkbox"/> Industry <input type="checkbox"/> Irrigation <input type="checkbox"/> Air conditioning <input type="checkbox"/> Stock <input type="checkbox"/> Lawn <input type="checkbox"/> Oil field water <input type="checkbox"/> Other					
9. Casing: Material <u>PE</u> Height: <u>Above</u> or below Threaded <input type="checkbox"/> Welded <input type="checkbox"/> Surface <u>12</u> in. RMP <input type="checkbox"/> PVC <input checked="" type="checkbox"/> Weight <u>12</u> lbs./ft. Dia. <u>5</u> in. to <u>53</u> ft. depth Wall Thickness: inches or Dia. <u>5</u> in. to <u>53</u> ft. depth gage No. <u>14</u>					
10. Screen: Manufacturer's name <u>Can Top</u> Type <u>160</u> Dia. <u>5 in</u> Slot/gauze <u>3/16</u> Length <u>11 ft.</u> Set between <u>42</u> ft. and <u>53</u> ft. Gravel pack? <input checked="" type="checkbox"/> Size range of material <u>1/4 in</u>					
11. Static water level: <u>30</u> ft. below land surface Date <u>6/15/77</u> mo./day/yr.					
12. Pumping level below land surfaces: <u>46</u> ft. after <u>1</u> hrs. pumping <u>10</u> g.p.m. ft. after <u> </u> hrs. pumping <u> </u> g.p.m. Estimated maximum yield <u>15</u> g.p.m.					
13. Water sample submitted: <u>Yes</u> <input checked="" type="checkbox"/> No <input type="checkbox"/> Date <u>6/17/77</u> mo./day/yr.					
14. Well head completion: <input checked="" type="checkbox"/> Pitless adapter <u>14</u> inches above grade					
15. Well grouted? <input checked="" type="checkbox"/> With: <input type="checkbox"/> Neat cement <input type="checkbox"/> Bentonite <input checked="" type="checkbox"/> Concrete Depth: From <u>1</u> ft. to <u>10</u> ft.					
16. Nearest source of possible contamination: ft. <u>100</u> Direction <u>West</u> Type <u>creek</u> Well disinfected upon completion? <input checked="" type="checkbox"/> Yes <input type="checkbox"/> No					
17. Pump: <input checked="" type="checkbox"/> Not installed Manufacturer's name <u>Mayer</u> Model number <u>24500</u> HP <u>1/2</u> Volts <u>220</u> Length of drop pipe <u>40</u> ft. capacity <u>15</u> g.p.m. Type: <input checked="" type="checkbox"/> Submersible <input type="checkbox"/> Turbine <input type="checkbox"/> Jet <input type="checkbox"/> Reciprocating <input type="checkbox"/> Centrifugal <input type="checkbox"/> Other					
18. Elevation:	19. Remarks:				
Topography: <input type="checkbox"/> Hill <input checked="" type="checkbox"/> Slope <input type="checkbox"/> Upland <input type="checkbox"/> Valley	20. Water well contractor's certification: This well was drilled under my jurisdiction and this report is true to the best of my knowledge and belief. <u>CARL THOMAS & SON</u> 247 Business name <u>333 E 16th St Concordia, KS</u> License No. <u> </u> Signature <u>Carl Thomas</u> Date <u>9/20/77</u> Authorized Representative				

T 5 S
 R 2 E
 Sec 32
 Sub SW 1/4