USE TYPEWRITER OR BALL POINT PEN-PRESS FIRMLY, PRINT CLEARLY.

WATER WELL RECORD
KSA 82a-1201-1215

Kansas Department of Health and Environment-Division of Environment
(Water well Contractors)
Topeka, Kansas 66620

1. Location of well:	County: Cloud	Fraction: SE 1/4 NE 1/4 SE 1/4	Section number: 35	Township number: T 5 S	Range number: R 2 E (W)

2. Distance and direction from nearest town or city: 8E 1/8 S of Concordia, Ks
Street address of well location if in city:

3. Owner of well: Allen Engle
R.R. or street:
City, state, zip code: Concordia Ks 66901

4. Locate with "X" in section below:

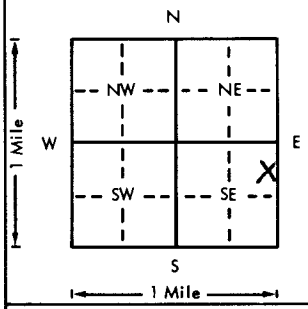

Sketch map:

6. Bore hole dia. 8 in. Completion date 10-13-77
Well depth 80 ft.

7. __ Cable tool X Rotary __ Driven __ Dug
__ Hollow rod __ Jetted __ Bored __ Reverse rotary

8. Use: X Domestic __ Public supply __ Industry
__ Irrigation __ Air conditioning __ Stock
__ Lawn __ Oil field water __ Other

9. Casing: Material PVC Height: Above ~~or below~~
Threaded ___ Welded X Surface 12 in.
RMP ___ PVC X Weight 3 lbs./ft.
Dia. 5 in. to 80 ft. depth Wall Thickness: inches or
Dia. ___ in. to ___ ft. depth gage No. 058

10. Screen: Manufacturer's name Pumpco
Type PVC Dia. 5"
Slot/~~gauze~~ 1/16" Length 10'
Set between 70 ft. and 80 ft.
___ ft. and ___ ft.
Gravel pack? YES Size range of material 1/16-1/4

11. Static water level: mo./day/yr.
14 ft. below land surface Date 10-13-77

12. Pumping level below land surfaces:
___ ft. after 1/2 hrs. pumping 35 g.p.m.
___ ft. after ___ hrs. pumping ___ g.p.m.
Estimated maximum yield 35 g.p.m.

13. Water sample submitted: mo./day/yr.
___ Yes X No Date

14. Well head completion:
___ Pitless adapter 12 Inches above grade

15. Well grouted? YES
With: ___ Neat cement ___ Bentonite X Concrete
Depth: From 0 ft. to 10 ft.

16. Nearest source of possible contamination: NONE
ft. ___ Direction ___ Type ___
Well disinfected upon completion? X Yes ___ No

17. Pump: X Not installed
Manufacturer's name
Model number ___ HP ___ Volts ___
Length of drop pipe ___ ft. capacity ___ g.p.m.
Type:
___ Submersible ___ Turbine
___ Jet ___ Reciprocating
___ Centrifugal ___ Other

5. Type and color of material	From	To
Clay	0	18
sand rock	18	60
clay	60	72
sand rock	72	80
stop in sand rock		

(Use a second sheet if needed)

T 5 R 2 E (W) Sec 35 SE/4 SE/4 SE/4

18. Elevation: 390
Topography:
X Hill
___ Slope
___ Upland
___ Valley

19. Remarks:

20. Water well contractor's certification:
This well was drilled under my jurisdiction and this report is true to the best of my knowledge and belief.
Geo Cox & Son Inc 258
Business name License No.
Address Clifton, Kansas 66937
Signed Francis Cox Date 10-18-77
Authorized representative

Forward the white, blue and pink copies to the Department of Health and Environment

Form WWC-5

MI-1023