


1 LOCATION OF WATER WELL:		Fraction	Section Number		Township Number	Range Number
County:	PHILLIPS	N 1/4 SW 1/4 SW 1/4	16	T 5 S	R 20	E/W

1 LOCATION OF WATER WELL:		Fraction	Section Number		Township Number	Range Number
County:	PHILLIPS	N 1/4 SW 1/4 SW 1/4	16	T 5 S	R 20	E/W

Distance and direction from nearest town or city street address of well if located within city?
3 miles South and 1/2 mile west of Logan KS

2	WATER WELL OWNER:	KEN WILKISON	
	RR#, St. Address, Box # :	306 W MAPLE	Board of Agriculture, Division of Water Resources
	City, State, ZIP Code :	LOGAN KS 67646	Application Number:

3. LOCATE WELL'S LOCATION WITH AN "X" IN SECTION BOX: 4. DEPTH OF COMPLETED WELL: 38 ft. ELEVATION:
Depth(s) Groundwater Encountered 1. 20 ft. 2. ft. 3. ft.

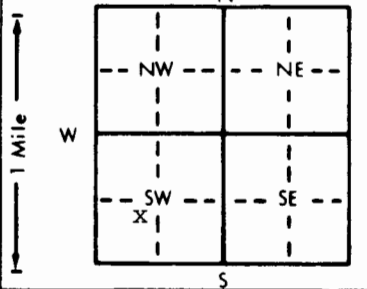

WELL'S STATIC WATER LEVEL 20 ft. below land surface measured on mo/day/yr 4-23-97

Pump test data: Well water was _____ ft. after _____ hours pumping _____ gpm

Est. Yield 40 gpm: Well water was _____ ft. after _____ hours pumping _____ gpm

Bore Hole Diameter 10 in. to 38 ft., and _____ in. to _____ ft.

WELL WATER TO BE USED AS:

5 Public water supply	8 Air conditioning	11 Injection well		
XX Domestic	3 Feedlot	6 Oil field water supply	9 Dewatering	12 Other (Specify below)
2 Irrigation	4 Industrial	7 Lawn and garden only	10 Monitoring well	

Was a chemical/bacteriological sample submitted to Department? Yes _____ No XX; If yes, mo/day/yr sample was submitted

Water Well Disinfected? Yes _____ No XX

5 TYPE OF BLANK CASING USED:		5 Wrought iron	8 Concrete tile	CASING JOINTS: Glued <u>XX</u> Clamped
1 Steel	3 RMP (SR)	6 Asbestos-Cement	9 Other (specify below)	Welded
XX2 PVC	4 ABS	7 Fiberglass		Threaded
Blank casing diameter 5 in. to 20 ft. Dia		in. to ft. Dia in. to ft.		
Casing height above land surface 18 in.		weight 160 lbs./ft. Wall thickness or gauge No.		

TYPE OF SCREEN OR PERFORATION MATERIAL:		XX PVC		10 Asbestos-cement	
1 Steel	3 Stainless steel	5 Fiberglass	8 RMP (SR)	11 Other (specify)	
2 Brass	4 Galvanized steel	6 Concrete tile	9 ABS	12 None used (open hole)	
SCREEN OR PERFORATION OPENINGS ARE:		5 Gauzed wrapped		8 Saw cut	
1 Continuous slot	XX Mill slot	6 Wire wrapped		9 Drilled holes	
2 Louvered shutter	4 Key punched	7 Torch cut		10 Other (specify)	
SCREEN-PERFORATED INTERVALS:		From 20	ft. to 38	ft., From	ft. to ft.
		From	ft. to 38	ft., From	ft. to ft.
GRAVEL PACK INTERVALS:		From 20	ft. to 38	ft., From	ft. to ft.
		From	ft. to	ft., From	ft. to ft.

6 GROUT MATERIAL: 0 Neat cement 2 Cement grout ~~3~~ Bentonite 4 Other

Grout Intervals: From ft. to ft., From ft. to ft., From ft. to ft.

What is the nearest source of possible contamination:

1 Septic tank	4 Lateral lines	7 Pit privy	10 Livestock pens	14 Abandoned water well
2 Sewer lines	5 Cess pool	8 Sewage lagoon	11 Fuel storage	15 Oil well/Gas well
3 Watertight sewer lines	6 Seepage pit	9 Feedyard	12 Fertilizer storage	16 Other (specify below)
			13 Insecticide storage	

Direction from well? How many feet?

[illegible]