

USE TYPEWRITER OR BALL POINT PEN-PRESS FIRMLY, PRINT CLEARLY.

NORTON 4SW


WATER WELL RECORD
KSA 82a-1201-1215

ABB

Kansas Department of Health and Environment-Division of Environment
(Water well Contractors)
Topeka, Kansas 66620

1. Location of well: County Norton Fraction NE 1/4 NW 1/4 NE 1/4 Section number 14 Township number T 5 S R 21 E/W Range number

2. Distance and direction from nearest town or city: HE 25 mi East Densmore, Kan
Street address of well location if in city:
3. Owner of well: John Kemper
R.R. or street:
City, state, zip code: Logan, Kan.

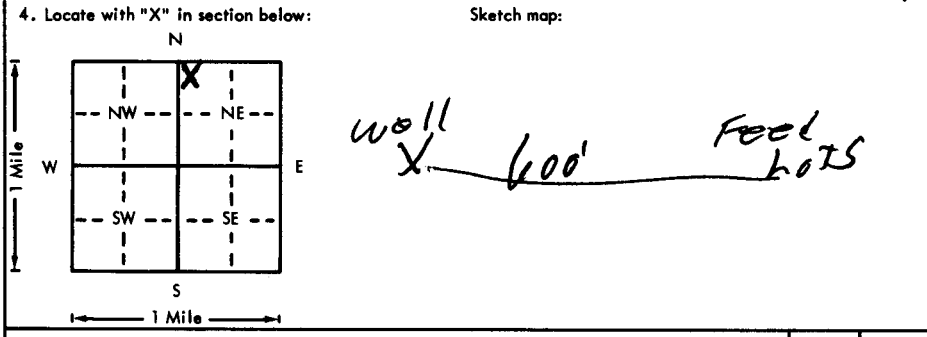

6. Bore hole dia. 9 in. Completion date 4-6-72
Well depth 35 ft.
7. Cable tool Rotary Driven Aug
 Hollow rod Jetted Bored Reverse rotary
8. Use: Domestic Public supply Industry
 Irrigation Air conditioning Stock
 Lawn Oil field water Other
9. Casing: Material plastic Height: Above or below
Threaded Welded Surface 24 in.
RMP PVC Weight 35 lbs./ft.
Dia. 5 in. to 35 ft. depth Wall Thickness: inches or
Dia. 1/2 in. to 35 ft. depth Gage No. 2250

5. Type and color of material	From	To
<u>clay</u>	<u>0</u>	<u>10</u>
<u>sand & clay STRIPS</u>	<u>10</u>	<u>35</u>
<u>BROCK ?</u>		
<u>NO</u>		
<u>1/4</u>		

10. Screen: Manufacturer's name JESS
LOGAN
Type plastic Dia. 5"
Slot gauge 1/4" Length 10'
Set between 35' ft. and 35' ft.
Gravel pack? Size range of material 1/4" to 1/2"
11. Static water level: 16 ft. below land surface Date 4-6-72
12. Pumping level below land surfaces:
10 ft. after 10 hrs. pumping 10 g.p.m.
10 ft. after 10 hrs. pumping 10 g.p.m.
Estimated maximum yield 10 g.p.m.
13. Water sample submitted: NO mo./day/yr.
Yes No Date
14. Well head completion:
10 Pitless adapter 10 inches above grade
15. Well grouted? YES
With: Neat cement Bentonite Concrete
Depth: From 0 ft. to 10 ft.
16. Nearest source of possible contamination: FOOD
ft. 600 Direction EAST Type well
Well disinfected upon completion? Yes No
17. Pump: Not installed
Manufacturer's name _____
Model number _____ HP _____ Volts _____
Length of drop pipe _____ ft. capacity _____ g.p.m.
Type:
 Submersible Turbine
 Jet Reciprocating
 Centrifugal Other

18. Elevation:
Topography:
 Hill
 Slope
 Upland
 Valley

19. Remarks:
client will run cement
slab. 2013 (TOPO)

20. Water well contractor's certification:
This well was drilled under my jurisdiction and this report is true to the best of my knowledge and belief.
D&H Drilling Co 303
Business name License No.
Address Hill City, Kan
Signed allan J. Soust Date 4/18/72
Authorized representative

- 5
2
10
14
Norton NE
1/4 1/4 1/4