

USE TYPEWRITER OR BALL POINT PEN-PRESS FIRMLY, PRINT CLEARLY.

Logan NW


WATER WELL RECORD
KSA 82a-1201-1215

Kansas Department of Health and Environment-Division of Environment
(Water well Contractors)
Topeka, Kansas 66620

DODD

Location of well: **NORTON** County **Small town** Fraction **SE 1/4 SE 1/4 SE 1/4** Section number **14** Township number **T 5 S R 21** Range number **21** NW

Distance and direction from town or city: **4 miles E & 4 miles South of** 3. Owner of well: **John Kemper**
Street address of well location if in city: **DENSMORE, Ks.** R.R. or street: **APR. #2**
City, state, zip code: **LOGAN, Ks. 67646**

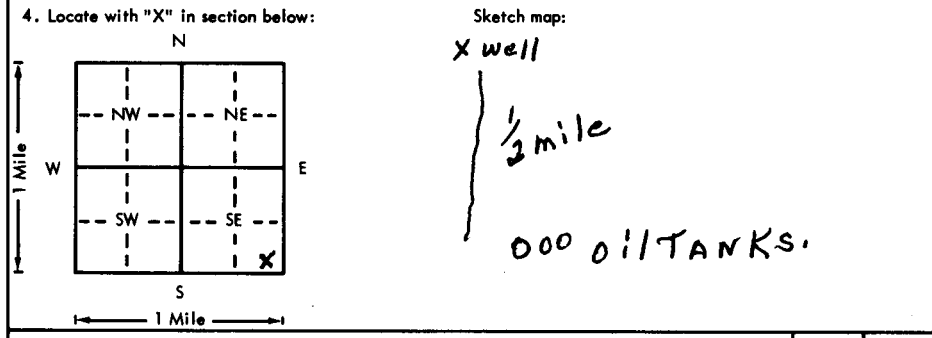

6. Bore hole dia. **9** in. Completion date **4/27/77**
Well depth **84** ft.
7. Cable tool Rotary Driven Dug
 Hollow rod Jetted Bored Reverse rotary
8. Use: Domestic Public supply Industry
 Irrigation Air conditioning Stock
 Lawn Oil field water Other
9. Casing: Material **pist** Height: Above or below
Threaded Welded **91** Surface **18** in.
RMP PVC Weight _____ lbs./ft.
Dia. **5** in. to _____ ft. depth Wall Thickness: inches or
Dia. _____ in. to _____ ft. depth gage No. **250**

5. Type and color of material	From	To
Clay & Rock ledges	0	69
SAND & Clay STRIPS	69	79
CLAY - (yellow)	79	83
Shale	83	84
BROCK 79 1/4		
79		
22		
57' soil thick	2140	
	79	
	2061'	
in Og		

10. Screen: Manufacturer's name **Jess E Lowell**
Type **PLASTIC** Dia. **5"**
Slat/gauze **1/4"** Length **10'**
Set between **74** ft. and **84** ft.
Gravel pack? Size range of material **1/4 - 3/8"**
11. Static water level: _____ mo./day/yr.
22 ft. below land surface Date **4/27/77**
12. Pumping level below land surfaces: **NOT PUMPED**
_____ ft. after _____ hrs. pumping _____ g.p.m.
_____ ft. after _____ hrs. pumping _____ g.p.m.
Estimated maximum yield _____ g.p.m.
13. Water sample submitted: _____ mo./day/yr.
Yes No Date _____
14. Well head completion: **NOT done**
 Pitless adapter _____ inches above grade
15. Well grouted? **yes**
With: Neat cement Bentonite Concrete
Depth: From **0** ft. to **10** ft.
16. Nearest source of possible contamination: **oil**
ft. **1/2 mile** Direction **South** Type **TANKS**
Well disinfected upon completion? Yes No
17. Pump: Not installed
Manufacturer's name _____
Model number _____ HP _____ Volts _____
Length of drop pipe _____ ft. capacity _____ g.p.m.
Type: _____
 Submersible Turbine
 Jet Reciprocating
 Centrifugal Other

18. Elevation: _____ Topography: Hill _____ Slope _____ Upland _____ Valley _____
19. Remarks: **Owner To install concrete slab AT Ground surface.**
2140
20. Water well contractor's certification: This well was drilled under my jurisdiction and this report is true to the best of my knowledge and belief.
D&L Drilling Co. 303
Business name _____ License No. _____
Address **2368 Hill City, Ks 67842**
Signed **Alan J. [Signature]** Date **5/4/77**
Authorized Representative