USE TYPEWRITER OR BALL POINT PEN-PRESS FIRMLY, PRINT CLEARLY.

Edmond

T	R	EW	sec	1/4	1/4	1/4	No.

WATER WELL RECORD
KSA 82a-1201-1215

BBD

Kansas State Dept. Of Health
(Water Well Contractors)
Forbes-Bldg. 740
Topeka, Kansas 66620

1 Location of well:	County	Township name	Fraction	Section number	Town number	Range number
	NORTON		SENWNW	9	5	22

Distance and direction from nearest town or city: 1 E 1/4 mi North of Edmond, Kan

Street address of well location if in city:

3 Owner of well: Vernon Jacobs

Address: Edmond, Ks.

Locate with "X" in section below:

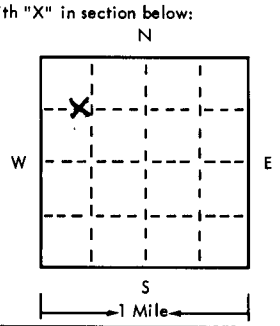

Sketch map:

4 Well depth: 79 ft. Date of completion 7-21-76
Well diameter 28 in.

5 ☐ Cable tool ☐ Rotary ☐ Driven ☐ Dug
☐ Hollow rod ☐ Jetted ☐ Bored ☑ Reverse rotary

6 Use: ☐ Domestic ☐ Public supply ☐ Industry
☑ Irrigation ☐ Air conditioning ☐ Commercial
☐ Test well ☐

7 Casing: Material CR Height: above/below
Threaded ☐ Welded ☐ Surface 12 in.
Diam. BANDED Weight 30 lbs./ft.
16 in. to 79 ft. depth Drive shoe? ☐ Yes ☑ No
___ in. to ___ ft. depth

8 Screen:
Manufacturer Johnson casing
Type CA Dia. 16"
Slot/gauze 36 Length 52'
Set between 27 ft. and 79 ft.
Fittings:
Gravel pack ☑ Yes ☐ No Size range of material 1/4-5/8

9 Static water level:
29 ft. below land surface Date 7-21-76

10 Pumping level below land surfaces:
79 ft. after 4 hrs. pumping 400 g.p.m.
___ ft. after ___ hrs. pumping ___ g.p.m.
Estimated maximum yield 400 g.p.m.

11 Water sample submitted:
☐ Yes ☑ No Date

12 Well head completion: NOT done
☐ Pitless adapter ☐ Inches above grade

13 Well grouted? ☑ Yes ☐ No
☑ Neat cement ☐ Bentonite ☐
Depth: From 0 ft. to 16 ft.

14 Nearest source of possible contamination: Barn
ft. 300 Direction North Type Lot
Well disinfected upon completion? ☐ Yes ☑ No

15 Pump: ☑ Not installed
Manufacturer's name
Model number HP Volts
Length of drop pipe ft. capacity g.m.p.
Type:
☐ Submersible ☐ Turbine
☐ Jet ☐ Reciprocating
☐ Certrifugal ☐ Other

2

Type and color of material	From	To
Brown Clay	0	38
Sand & med. gravel with		
occasional mud streaks	38	75
Hard blue shale	75	79
BROCK 72'		
29 ft		
43' sat thick		
72		
29		
43' sat thick NOT in Oy		

(use a second sheet if needed)

16 Remarks: elevation

2130
72
2058

Topography:
☐ Hill
☑ Slope
☐ Upland
☐ Valley

17 Water well contractor's certification:
This well was drilled under my jurisdiction and this report is true to the best of my knowledge and belief.
DLL Drilling 303
Business name License No.
Address Hill City Kan.
Signed [illegible] Date 7-25-76
Authorized representative

5 22 W 9 SENWNW

Forward the white, blue and pink copies to the Kansas State Dept. Of Health.

Form WWC-5