

USE TYPEWRITER OR BALL POINT PEN-PRESS FIRMLY, PRINT CLEARLY.


710 MON RD

DCB WATER WELL RECORD KSA 82a-1201-1215

Kansas Department of Health and Environment-Division of Environment (Water well Contractors) Topeka, Kansas 66620

1. Location of well: County Norton Fraction 2 1/4 5/4 SE 1/4 Section number 11 Township number T 5 S Range number R 22 E/W

2. Distance and direction from nearest town or city: 3 Ed 25 Street address of well location if in city: Edmond, Kan. 3. Owner of well: Joe Stenger R.R. or street: RD. City, state, zip code: Donsmore, Kan

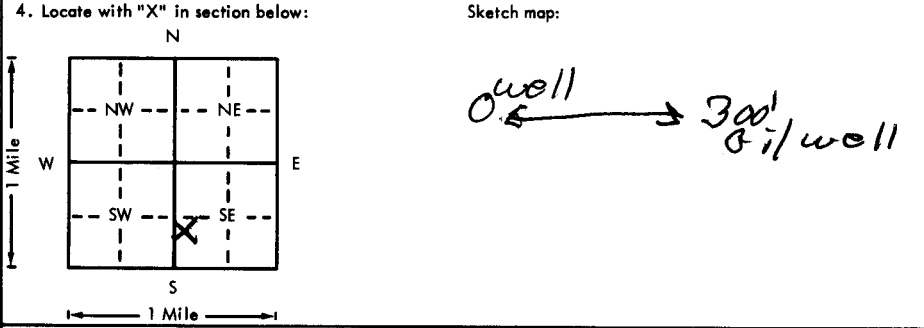

6. Bore hole dia. 7 1/8 in. Completion date 7-14-76 Well depth 76 ft.  
 7.  Cable tool  Rotary  Driven  Dug  Hollow rod  Jetted  Bored  Reverse rotary  
 8. Use:  Domestic  Public supply  Industry  Irrigation  Air conditioning  Stock  Lawn  Oil field water  Other

5. Type and color of material	From	To
Brown & Gray clay	0	56
Sand & med gravel	56	76
Blue shale	76	78
ROCK 76'		
40'		
36' sat thick		
Not in Og		

9. Casing: Material Cement Height: Above or below 6 in. Threaded Welded Surface 6 in. RMP PVC Weight 15 lbs./ft. Dia. 1 1/2 in. to 30 ft. depth Wall Thickness: inches or Dia. 1/8 in. to 30 ft. depth gage No. 7 1/8  
 10. Screen: Manufacturer's name Johnson ASS. Co. Type Cement Dia. 1 1/2 in. Slot/gauze 3/16 Length 26' Set between 52 ft. and 78 ft. Gravel pack?  Size range of material 1/4 to 7/8

11. Static water level: 40 ft. below land surface Date 7-14-76 mo./day/yr.

12. Pumping level below land surfaces: 76 ft. after 6 hrs. pumping 456 g.p.m. Estimated maximum yield 450 g.p.m.

13. Water sample submitted:  Yes  No Date \_\_\_\_\_ mo./day/yr.

14. Well head completion:  Pitless adapter \_\_\_\_\_ inches above grade

15. Well grouted?  Yes  No With:  Neat cement  Bentonite  Concrete Depth: From 0 ft. to 16 ft.

16. Nearest source of possible contamination: ft. 300 Direction East Type Oil well Wall disinfected upon completion?  Yes  No

17. Pump:  Not installed Manufacturer's name \_\_\_\_\_ Model number \_\_\_\_\_ HP \_\_\_\_\_ Volts \_\_\_\_\_ Length of drop pipe \_\_\_\_\_ ft. capacity \_\_\_\_\_ g.p.m. Type:  Submersible  Turbine  Jet  Reciprocating  Centrifugal  Other

18. Elevation: \_\_\_\_\_ Topography:  Hill  Slope  Upland  Valley  
 19. Remarks: 2090 (1010)  
2014

20. Water well contractor's certification: This well was drilled under my jurisdiction and this report is true to the best of my knowledge and belief.  
Bill Danling Co Business name License No. 303  
 Address Hill City, Kan  
 Signed Bill Danling Date 7-28-76 Authorized representative

5 22 E  
 R  
 W  
 11  
 Sec  
 1/4 1/4 1/4 1/4  
 NWSE