

USE TYPEWRITER OR BALL POINT PEN-PRESS FIRMLY, PRINT CLEARLY.

*Edmond*

T R EW sec 1/4 1/4 1/4 No.


WATER WELL RECORD  
KSA 82a-1201-1215

Kansas State Dept. Of Health  
(Water Well Contractors)  
Forbes-Bldg. 740  
Topeka, Kansas 66620

*CAA*

1 Location of well: County *Norton* Township name *Salomon* Fraction *NE 1/4 SW 1/4* Section number *15* Town number *5* Range number *22*

Distance and direction from nearest town or city: *1 mi. South 1 1/2 East of Edmond Mo.*  
3 Owner of well: *Kenneth Reimen*  
Street address of well location if in city: *Edmond Mo.* Address: *Edmond, Kas*

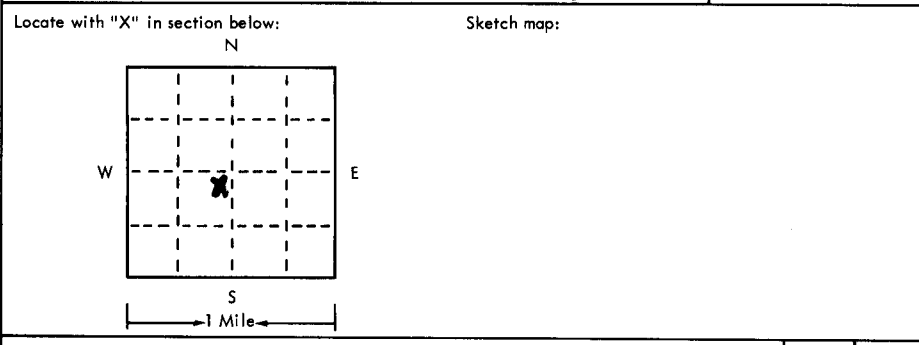

4 Well depth: *79* ft. Date of completion *6-1-75*  
Well diameter *20* in.  
5  Cable tool  Rotary  Driven  Dug  
 Hollow rod  Jetted  Bored  Reverse rotary  
6 Use:  Domestic  Public supply  Industry  
 Irrigation  Air conditioning  Commercial  
 Test well  
7 Casing: Material *Steel* Height: above/below  
Threaded  Welded  Surface *12* in.  
Diam. *12 3/4"* Weight *33* lbs./ft. *L*  
*0* in. to *79* ft. depth Drive shoe?  Yes  No  
*0* in. to *0* ft. depth

2	Type and color of material	From	To
	<i>Sandy clay</i>	<i>10</i>	<i>20</i>
	<i>Fine sand</i>	<i>20</i>	<i>30</i>
	<i>Clay + Sandy clay</i>	<i>30</i>	<i>50</i>
	<i>Sandy clay</i>	<i>50</i>	<i>64</i>
	<i>Med. Gravel</i>	<i>64</i>	<i>79</i>
	<i>BROCK ? 77 (est)</i>		
	<i>40' fm</i>		
	<i>37' sat thick</i>		
	<i>NOT in Og</i>		

8 Screen: Manufacturer *W. A. Brown*  
Type *Screen* Dia. *12 3/4*  
Slot/gauze *7-18* Length *20*  
Set between *79* ft. and *59* ft.  
Fittings: Gravel pack  Yes  No Size range of material *1/4 x 3/8*  
9 Static water level: *40* ft. below land surface Date *5-22-75*  
10 Pumping level below land surfaces: *75* ft. after *6* hrs. pumping *1000* g.p.m.  
*0* ft. after *0* hrs. pumping *0* g.p.m.  
Estimated maximum yield *1000* g.p.m.  
11 Water sample submitted:  Yes  No Date *00-00-00*  
12 Well head completion:  Pitless adapter *12* inches above grade  
13 Well grouted?  Yes  No  
 Neat cement  Bentonite   
Depth: From *0* ft. to *10* ft.  
14 Nearest source of possible contamination: ft. *None* Direction *None* Type *None*  
Well disinfected upon completion?  Yes  No  
15 Pump:  Not installed  
Manufacturer's name *Hault*  
Model number *7 x 12* HP *40* Volts *000*  
Length of drop pipe *70* ft. capacity *000* g.p.m.  
Type:  Submersible  Turbine  
 Jet  Reciprocating  
 Centrifugal  Other

16 Remarks: elevation *2111*  
*77*  
*2034*

Topography:  Hill  Slope  Upland  Valley

17 Water well contractor's certification:  
This well was drilled under my jurisdiction and this report is true to the best of my knowledge and belief.  
*Blue Jay Drilling Co. Inc.*  
Business name *Blue Jay Drilling Co. Inc.* License No. *214*  
Address *Box 503 Colby Kas*  
Signed *Monty Roll* Date *6-21-75*  
Authorized representative

*5*  
*raw*  
*15 NE NW SW*