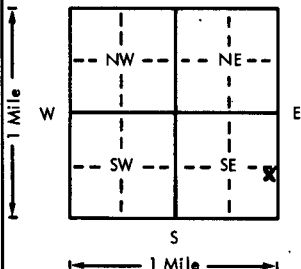


USE TYPEWRITER OR BALL
POINT PEN-PRESS FIRMLY,
PRINT CLEARLY.

WATER WELL RECORD
KSA 82a-1201-1215

Kansas Department of Health and
Environment-Division of Environment
(Water well Contractors)
Topeka, Kansas 66620

1. Location of well:	County	Fraction	Section number	Township number	Range number
	Norton	NE 1/4 SE 1/4 SE 1/4	12	T 5 S R 23 E/W	
2. Distance and direction from nearest town or city: 1 1/2 miles west 1/4 mile north of Street address of well location if in city: Edmond KS.			3. Owner of well: Bill Noone. R.R. or street: City, state, zip code: Denmore KS. 67633		
4. Locate with "X" in section below: Sketch map: 			6. Bore hole dia. 9 in. Completion date Well depth 26 ft. 10/06/76		
5. Type and color of material			7. Cable tool <input checked="" type="checkbox"/> Rotary <input type="checkbox"/> Driven <input type="checkbox"/> Dug <input type="checkbox"/> Hollow rod <input type="checkbox"/> Jetted <input type="checkbox"/> Bored <input type="checkbox"/> Reverse rotary		
Clay, TAN			8. Use: <input type="checkbox"/> Domestic <input type="checkbox"/> Public supply <input type="checkbox"/> Industry <input type="checkbox"/> Irrigation <input type="checkbox"/> Air conditioning <input checked="" type="checkbox"/> Stock <input type="checkbox"/> Lawn <input type="checkbox"/> Oil field water <input type="checkbox"/> Other		
SAND			9. Casing: Material <u>PESTIC</u> Height: <u>Above</u> or below Threaded <input type="checkbox"/> Welded <input type="checkbox"/> Surface <u>12</u> in. RMP <input type="checkbox"/> PVC <input checked="" type="checkbox"/> Weight <u>225</u> lbs./ft. Dia. <u>5</u> in. to <u>56</u> ft. depth Wall Thickness: inches or Dia. <u>5</u> in. to <u>56</u> ft. depth gage No. <u>5116</u>		
Shale			10. Screen: Manufacturer's name <u>MODERN PIPES INC.</u> Type <u>PVC</u> Dia. <u>5"</u> Slot gauge <u>-032</u> Length <u>30</u> Set between <u>56</u> ft. and <u>26</u> ft. ft. and ft. Gravel pack? <u>YES</u> Size range of material <u>1/4-1/4</u>		
BROCK 74'			11. Static water level: mo./day/yr. <u>53</u> ft. below land surface Date <u>10/06/76</u>		
53'			12. Pumping level below land surfaces: ft. after hrs. pumping g.p.m. ft. after hrs. pumping g.p.m. Estimated maximum yield <u>15</u> g.p.m.		
21' set thick			13. Water sample submitted: mo./day/yr. Yes <input checked="" type="checkbox"/> No <input type="checkbox"/> Date		
Possible < 1/4 from Ox contact probably in alluvium			14. Well head completion: Pitless adapter <u>12"</u> inches above grade		
			15. Well grouted? <u>YES</u> With: <input type="checkbox"/> Neat cement <input checked="" type="checkbox"/> Bentonite <input type="checkbox"/> Concrete Depth: From <u>0</u> ft. to <u>38</u> ft.		
			16. Nearest source of possible contamination: ft. <u>500</u> Direction <u>N</u> Type <u>RUN OFF</u> Well disinfected upon completion? <input checked="" type="checkbox"/> Yes <input type="checkbox"/> No		
			17. Pump: Not installed Manufacturer's name <u>ACRMOBA</u> Model number <u>50-5-33</u> HP <u>1/2</u> Volts <u>230</u> Length of drop pipe <u>20</u> ft. capacity <u>5</u> g.p.m. Type: <input checked="" type="checkbox"/> Submersible <input type="checkbox"/> Turbine <input type="checkbox"/> Jet <input type="checkbox"/> Reciprocating <input type="checkbox"/> Centrifugal <input type="checkbox"/> Other		
(Use a second sheet if needed)					
18. Elevation:			20. Water well contractor's certification: This well was drilled under my jurisdiction and this report is true to the best of my knowledge and belief. <u>Lawrence & Son Delf</u> 167 Business name License No. Address <u>Box 149 Norton KS</u> Signed <u>Lawrence</u> Date <u>10/11/76</u> Authorized representative		
19. Remarks: 2212 24 21 35					