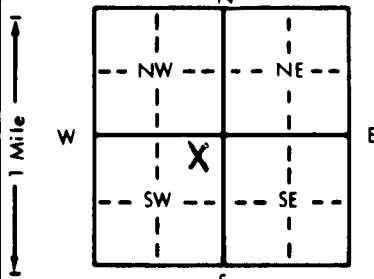


1 LOCATION OF WATER WELL: County: Norton	Fraction NE 1/4 NE 1/4 SW 1/4	Section Number 27	Township Number T 5 S	Range Number R 23
--	---	-----------------------------	---------------------------------	-----------------------------

Distance and direction from nearest town or city street address of well if located within city?

1 South 5 1/2 East 1/2 South of Lenora, Ks.

2 WATER WELL OWNER: Rod Krauss RR#, St. Address, Box # : 207 E. Lincoln City, State, ZIP Code : Norton, Ks. 67654	Board of Agriculture, Division of Water Resources Application Number:
--	--

3 LOCATE WELL'S LOCATION WITH AN "X" IN SECTION BOX: 	4 DEPTH OF COMPLETED WELL: 125 ft. ELEVATION: Depth(s) Groundwater Encountered 1. ft. 2. ft. 3. ft. WELL'S STATIC WATER LEVEL 90 ft. below land surface measured on mo/day/yr Pump test data: Well water was ft. after hours pumping gpm Est. Yield gpm: Well water was ft. after hours pumping gpm Bore Hole Diameter 8 in. to 125 ft., and in. to ft. WELL WATER TO BE USED AS: 5 Public water supply 8 Air conditioning 11 Injection well 1 Domestic 3 Feedlot 6 Oil field water supply 9 Dewatering 12 Other (Specify below) 2 Irrigation 4 Industrial 7 Lawn and garden only 10 Monitoring well Was a chemical/bacteriological sample submitted to Department? Yes.....No..... X ..; If yes, mo/day/yr sample was submitted Water Well Disinfected? Yes No X
--	--

5 TYPE OF BLANK CASING USED: 1 Steel 3 RMP (SR) 5 Wrought iron 8 Concrete tile 2 <u>PVC</u> 4 ABS 6 Asbestos-Cement 9 Other (specify below) 7 Fiberglass Blank casing diameter 4.5 in. to 105 ft., Dia. in. to ft., Dia. in. to ft. Casing height above land surface 18 in., weight 2.38 lbs./ft. Wall thickness or gauge No. 248 TYPE OF SCREEN OR PERFORATION MATERIAL: 1 Steel 3 Stainless steel 5 Fiberglass 7 <u>PVC</u> 10 Asbestos-cement 2 Brass 4 Galvanized steel 6 Concrete tile 8 RMP (SR) 11 Other (specify) 12 None used (open hole) SCREEN OR PERFORATION OPENINGS ARE: 1 Continuous slot 3 Mill slot 5 Gauzed wrapped 8 <u>Saw cut</u> 11 None (open hole) 2 Louvered shutter 4 Key punched 6 Wire wrapped 9 Drilled holes 7 Torch cut 10 Other (specify) SCREEN-PERFORATED INTERVALS: From 105 ft. to 125 ft., From ft. to ft. From ft. to ft., From ft. to ft. GRAVEL PACK INTERVALS: From 20 ft. to 125 ft., From ft. to ft. From ft. to ft., From ft. to ft.
--

6 GROUT MATERIAL: 1 Neat cement 2 Cement grout 3 <u>Bentonite</u> 4 Other Grout Intervals: From 0 ft. to 20 ft., From ft. to ft., From ft. to ft. What is the nearest source of possible contamination: NONE 1 Septic tank 4 Lateral lines 7 Pit privy 10 Livestock pens 14 Abandoned water well 2 Sewer lines 5 Cess pool 8 Sewage lagoon 11 Fuel storage 15 Oil well/Gas well 3 Watertight sewer lines 6 Seepage pit 9 Feedyard 12 Fertilizer storage 16 Other (specify below) 13 Insecticide storage Direction from well? How many feet?

FROM	TO	LITHOLOGIC LOG	FROM	TO	PLUGGING INTERVALS
0	3	Surface	106	121	Fine sand to med. sand
3	37	Clay & caliche	121	123	Ochre
37	42	Sand	123	125	Shale
42	46	Clay			
46	50	Sand & caliche			
50	58	Clay & caliche			
58	68	Fine sand to med. sand			
68	80	Clay & caliche			
80	85	Cemented sand			
85	90	Clay			
90	93	Fine sand			
93	95	Clay			
95	97	Sand			
97	105	Fine sand			
105	106	Caliche			

7 CONTRACTOR'S OR LANDOWNER'S CERTIFICATION: This water well was (1) constructed, (2) reconstructed, or (3) plugged under my jurisdiction and was completed on (mo/day/year) 9-24-91 and this record is true to the best of my knowledge and belief. Kansas Water Well Contractor's License No. 394 This Water Well Record was completed on (mo/day/yr) 9-25 under the business name of Woofter Pump & Well by (signature) <i>Walter Woofter</i>
--