

1 LOCATION OF WATER WELL:	Fraction	Section Number	Township Number	Range Number
County: Norton	SW 1/4 NE 1/4 NE 1/4	3	T 85 S	R 24 EW

Distance and direction from nearest town or city street address of well if located within city?

 $\frac{1}{2}$ mile East, 2 miles South, $\frac{1}{4}$ mile East of Lenora, Kansas

2 WATER WELL OWNER:


RR#, St. Address, Box # : DEAN JAMISON

Board of Agriculture, Division of Water Resources

City, State, ZIP Code : LENORA, KS. 67645

Application Number:

3 LOCATE WELL'S LOCATION WITH AN "X" IN SECTION BOX:

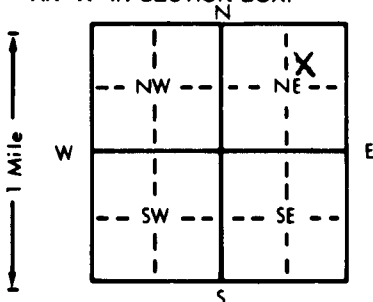

4 DEPTH OF COMPLETED WELL: 90' ft. ELEVATION:

Depth(s) Groundwater Encountered 1. ft. 2. ft. 3. ft.

WELL'S STATIC WATER LEVEL 36' ft. below land surface measured on mo/day/yr

Pump test data: Well water was ft. after hours pumping gpm

Est. Yield gpm: Well water was ft. after hours pumping gpm

Bore Hole Diameter 8 in. to 90 ft., and in. to ft.

WELL WATER TO BE USED AS: 5 Public water supply 8 Air conditioning 11 Injection well

1 Domestic 3 Feedlot 6 Oil field water supply 9 Dewatering 12 Other (Specify below)

2 Irrigation 4 Industrial 7 Lawn and garden only 10 Monitoring well

Was a chemical/bacteriological sample submitted to Department? Yes No X If yes, mo/day/yr sample was submittedWater Well Disinfected? Yes No X

5 TYPE OF BLANK CASING USED:

1 Steel 3 RMP (SR)

5 Wrought iron

8 Concrete tile

CASING JOINTS: Glued X Clamped

2 PVC 4 ABS

6 Asbestos-Cement

9 Other (specify below)

Welded

Blank casing diameter 4.5 in. to 90 ft., Dia in. to ft., Dia in. to ft.

7 Fiberglass

Threaded

Casing height above land surface 18 in., weight 2.38 lbs./ft. Wall thickness or gauge No. 248

TYPE OF SCREEN OR PERFORATION MATERIAL:

1 Steel 3 Stainless steel

5 Fiberglass

7 PVC

10 Asbestos-cement

2 Brass 4 Galvanized steel

6 Concrete tile

8 RMP (SR)

11 Other (specify)

9 ABS

12 None used (open hole)

SCREEN OR PERFORATION OPENINGS ARE:

1 Continuous slot 3 Mill slot

5 Gauzed wrapped

8 Saw cut

11 None (open hole)

2 Louvered shutter 4 Key punched

6 Wire wrapped

9 Drilled holes

7 Torch cut

10 Other (specify)

SCREEN-PERFORATED INTERVALS: From 70 ft. to 90 ft., From ft. to ft.

From ft. to ft., From ft. to ft.

GRAVEL PACK INTERVALS: From 20 ft. to 90 ft., From ft. to ft.

From ft. to ft., From ft. to ft.

6 GROUT MATERIAL:

1 Neat cement

2 Cement grout

3 Bentonite

4 Other

Grout Intervals: From 0 ft. to 20 ft., From ft. to ft., From ft. to ft.

What is the nearest source of possible contamination:

1 Septic tank 4 Lateral lines

7 Pit privy

10 Livestock pens

14 Abandoned water well

2 Sewer lines 5 Cess pool

8 Sewage lagoon

11 Fuel storage

15 Oil well/Gas well

3 Watertight sewer lines 6 Seepage pit

9 Feedyard

12 Fertilizer storage

16 Other (specify below)

13 Insecticide storage

Direction from well? NE

How many feet? 50'

FROM	TO	LITHOLOGIC LOG	FROM	TO	PLUGGING INTERVALS
0	3	Surface			
3	13	Silty Sand & Clay			
13	24	Sand & Clay Streaks			
24	30	Caliche & Fine Sand Streaks			
30	35	Caliche			
35	37	Clay			
37	45	Fine Sand			
45	59	Clay with Caliche Streaks			
59	61	Fine Sand			
61	70	Clay			
70	83	Fine Sand with Clay Strks			
83	85	Fine Sand			
85	90	Clay & Fine Sand Streaks			
90	100	Ochre			

7 CONTRACTOR'S OR LANDOWNER'S CERTIFICATION: This water well was (1) constructed, (2) reconstructed, or (3) plugged under my jurisdiction and was completed on (mo/day/year) 7-8-92 and this record is true to the best of my knowledge and belief. Kansas

Water Well Contractor's License No. 554

This Water Well Record was completed on (mo/day/yr) 7-8-92

under the business name of WOOFER PUMP & WELL, INC.

by (signature)