


1 LOCATION OF WATER WELL: Fraction NW 1/4 SW 1/4 SW 1/4 Section Number 14 Township Number T 5 S Range Number R 24 **NEW**

Distance and direction from nearest town or city street address of well if located within city?
 Located on North edge of Lenora

2 WATER WELL OWNER: City of Lenora
 RR#, St. Address, Box # : P.O. Box 331 Board of Agriculture, Division of Water Resources
 City, State, ZIP Code : Lenora, KS 67645 Application Number: 3729

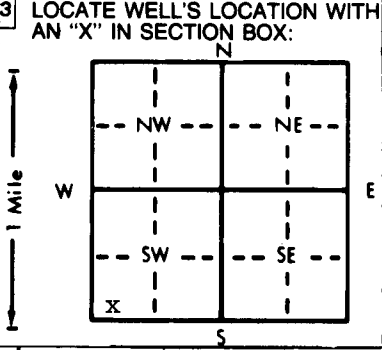

4 DEPTH OF COMPLETED WELL: 65 ft. ELEVATION: unknown
 Depth(s) Groundwater Encountered 1. 15 ft. 2. ft. 3. ft.
 WELL'S STATIC WATER LEVEL: 15 ft. below land surface measured on mo/day/yr 7/13/88
 Pump test data: Well water was not ck'd ft. after hours pumping gpm
 Est. Yield 500 gpm: Well water was ft. after hours pumping gpm
 Bore Hole Diameter: 30 in. to 59.5 ft., and in. to ft.
 WELL WATER TO BE USED AS:
 1 Domestic 3 Feedlot 6 Oil field water supply 8 Air conditioning 11 Injection well
 2 Irrigation 4 Industrial 7 Lawn and garden only 9 Dewatering 12 Other (Specify below)
 Was a chemical/bacteriological sample submitted to Department? Yes No; If yes, mo/day/yr sample was submitted 5/26/88
 Water Well Disinfected? Yes No

5 TYPE OF BLANK CASING USED:
 1 Steel 3 RMP (SR) 5 Wrought iron 8 Concrete tile CASING JOINTS: Glued Clamped
 2 PVC 4 ABS 6 Asbestos-Cement 9 Other (specify below) Welded
 7 Fiberglass Threaded
 Blank casing diameter: 16 in. to 34.5 ft., Dia 16 in. to 49.5 ft., Dia 16 in. to 59.5 ft.
 Casing height above land surface: 66 in., weight 62, 58 lbs./ft. Wall thickness or gauge No. 375
 TYPE OF SCREEN OR PERFORATION MATERIAL:
 1 Steel 3 Stainless steel 5 Fiberglass 7 PVC 10 Asbestos-cement
 2 Brass 4 Galvanized steel 6 Concrete tile 8 RMP (SR) 11 Other (specify)
 9 ABS 12 None used (open hole)
 SCREEN OR PERFORATION OPENINGS ARE:
 1 Continuous slot 3 Mill slot 5 Gauzed wrapped 8 Saw cut 11 None (open hole)
 2 Louvered shutter 4 Key punched 6 Wire wrapped 9 Drilled holes
 7 Torch cut 10 Other (specify) 100 slot
 SCREEN-PERFORATED INTERVALS: From 34.5 ft. to 41.5 ft., From ft. to ft.
 From 49.5 ft. to 56.5 ft., From ft. to ft.
 GRAVEL PACK INTERVALS: From 20 ft. to 59.5 ft., From ft. to ft.
 From ft. to ft., From ft. to ft.

6 GROUT MATERIAL: 1 Neat cement 2 Cement grout 3 Bentonite 4 Other
 Grout Intervals: From 0 ft. to 20 ft., From ft. to ft., From ft. to ft.
 What is the nearest source of possible contamination:
 1 Septic tank 4 Lateral lines 7 Pit privy 10 Livestock pens 14 Abandoned water well
 2 Sewer lines 5 Cess pool 8 Sewage lagoon 11 Fuel storage 15 Oil well/Gas well
 3 Watertight sewer lines 6 Seepage pit 9 Feedyard 12 Fertilizer storage 16 Other (specify below)
 13 Insecticide storage no known source

Direction from well? How many feet?

FROM	TO	LITHOLOGIC LOG	FROM	TO	LITHOLOGIC LOG
0	10	Topsoil & tan clay			
10	41.5	Sand & gravel, fine to very fine to med. some coarse			
41.5	49.5	soft black clay			
<input checked="" type="checkbox"/> 49.5	56.5	Sand & gravel, fine to very fine some med. w/couple thin clay streaks			
56.5	59.5	Black shale			

7 CONTRACTOR'S OR LANDOWNER'S CERTIFICATION: This water well was (1) constructed, (2) reconstructed, or (3) plugged under my jurisdiction and was completed on (mo/day/year) 7/13/88 and this record is true to the best of my knowledge and belief. Kansas Water Well Contractor's License No. 185 This Water Well Record was completed on (mo/day/yr) 8/2/88 under the business name of Clarke Well & Equipment, Inc. by (signature)

INSTRUCTIONS: Use typewriter or ball point pen. PLEASE PRESS FIRMLY and PRINT clearly. Please fill in blanks, underline or circle the correct answers. Send top three copies to Kansas Department of Health and Environment, Bureau of Water Protection, Topeka, Kansas 66620-7320, Telephone: 913-862-9360. Send one to WATER WELL OWNER and retain one for your records.