

1 LOCATION OF WATER WELL:	Fraction	Section Number	Township Number	Range Number
County: <u>Norton</u>	<u>NW 1/4 NW 1/4 NW 1/4</u>	<u>21</u>	T <u>5</u> S	R <u>24</u> E/W

Distance and direction from nearest town or city street address of well if located within city?


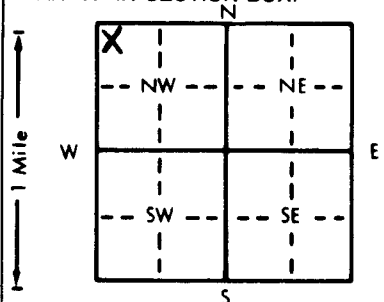
RR#, St. Address, Box # :

City, State, ZIP Code :

Board of Agriculture, Division of Water Resources

Application Number:

3 LOCATE WELL'S LOCATION WITH AN "X" IN SECTION BOX:

4 DEPTH OF COMPLETED WELL: 56 ft. ELEVATION:Depth(s) Groundwater Encountered 1. 30 ft. 2. ft. 3. ft.WELL'S STATIC WATER LEVEL 30 ft. below land surface measured on mo/day/yr 4-20-94

Pump test data: Well water was ft. after hours pumping gpm

Est. Yield 40 gpm: Well water was ft. after hours pumping gpmBore Hole Diameter 10 in. to 56 ft., and in. to ft.

WELL WATER TO BE USED AS: 5 Public water supply 8 Air conditioning 11 Injection well

1 Domestic 3 Feedlot 6 Oil field water supply 9 Dewatering 12 Other (Specify below)

2 Irrigation 4 Industrial 7 Lawn and garden only 10 Monitoring well

Was a chemical/bacteriological sample submitted to Department? Yes No ☒ If yes, mo/day/yr sample was submittedWater Well Disinfected? Yes ☒ No

5 TYPE OF BLANK CASING USED:

1 Steel

3 RMP (SR)

5 Wrought iron

8 Concrete tile

CASING JOINTS: Glued ☒ Clamped

2 PVC

4 ABS

6 Asbestos-Cement

9 Other (specify below)

Welded

Blank casing diameter

5 in.

7 Fiberglass

ft., Dia

in. to

Threaded

Casing height above land surface 24 in., weight 160 lbs./ft. Wall thickness or gauge No.

TYPE OF SCREEN OR PERFORATION MATERIAL:

1 Steel

3 Stainless steel

5 Fiberglass

7 PVC

10 Asbestos-cement

2 Brass

4 Galvanized steel

6 Concrete tile

8 RMP (SR)

11 Other (specify)

9 ABS

12 None used (open hole)

SCREEN OR PERFORATION OPENINGS ARE:

1 Continuous slot

3 Mill slot

5 Gauzed wrapped

8 Saw cut

11 None (open hole)

2 Louvered shutter

4 Key punched

6 Wire wrapped

9 Drilled holes

SCREEN-PERFORATED INTERVALS:

From 40 ft. to 56 ft.

From ft. to ft.

From ft. to ft.

GRAVEL PACK INTERVALS:

From 30 ft. to 56 ft.

From ft. to ft.

From ft. to ft.

6 GROUT MATERIAL:

1 Neat cement

2 Cement grout

3 Bentonite

4 Other

Grout Intervals: From 0 ft. to 30 ft., From ft. to ft., From ft. to ft.

What is the nearest source of possible contamination:

1 Septic tank

4 Lateral lines

7 Pit privy

10 Livestock pens

14 Abandoned water well

2 Sewer lines

5 Cess pool

8 Sewage lagoon

11 Fuel storage

15 Oil well/Gas well

3 Watertight sewer lines

6 Seepage pit

9 Feedyard

12 Fertilizer storage

16 Other (specify below)

13 Insecticide storage

none

Direction from well?

How many feet?

FROM	TO	LITHOLOGIC LOG	FROM	TO	PLUGGING INTERVALS
0	12	Surface Clay			
12	18	Hard yellow Clay			
18	26	Gray Clay			
26	35	Fine sand			
35	45	med. sand			
45	56	med to large sand			

7 CONTRACTOR'S OR LANDOWNER'S CERTIFICATION: This water well was (1) constructed (2) reconstructed, or (3) plugged under my jurisdiction and was

completed on (mo/day/year) 4-19-94 and this record is true to the best of my knowledge and belief. KansasWater Well Contractor's License No. 444This Water Well Record was completed on (mo/day/yr) 4-20-94under the business name of Anderson Drillingby (signature) Andy Anderson