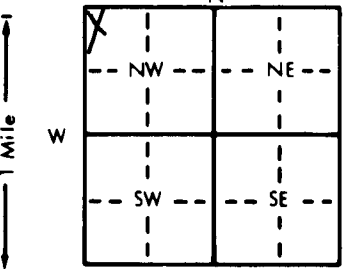


1 LOCATION OF WATER WELL:		Fraction	Section Number	Township Number	Range Number
County: <u>Norton</u>		<u>NW 1/4 NW 1/4 NW 1/4</u>	<u>23</u>	<u>T 5 S</u>	<u>R 24 E</u>
Distance and direction from nearest town or city street address of well if located within city? <u>SE corner Washington & Main; W Hwy 9, Lenora, KS</u>					
2 WATER WELL OWNER:		Board of Agriculture, Division of Water Resources			
RR#, St. Address, Box #:		Application Number:			
City, State, ZIP Code:					
3 LOCATE WELL'S LOCATION WITH AN "X" IN SECTION BOX:		4 DEPTH OF COMPLETED WELL: <u>39.0</u> ft. ELEVATION: <u>NA</u>			
		Depth(s) Groundwater Encountered 1. <u>NA</u> ft. 2. <u>NA</u> ft. 3. <u>NA</u> ft. WELL'S STATIC WATER LEVEL <u>NA</u> ft. below land surface measured on mo/day/yr <u>NA</u> Pump test data: Well water was _____ ft. after _____ hours pumping _____ gpm Est. Yield _____ gpm; Well water was _____ ft. after _____ hours pumping _____ gpm Bore Hole Diameter <u>8</u> in. to _____ ft., and _____ in. to _____ ft. WELL WATER TO BE USED AS: 1 Domestic 3 Feedlot 6 Oil field water supply 9 Dewatering 11 Injection well 2 Irrigation 4 Industrial 7 Lawn and garden only <u>10 Monitoring well</u> 12 Other (Specify below) Was a chemical/bacteriological sample submitted to Department? Yes _____ No <u>X</u> ; If yes, mo/day/yr sample was submitted _____ Water Well Disinfected? Yes _____ No <u>X</u>			
5 TYPE OF BLANK CASING USED:		CASING JOINTS: Glued _____ Clamped _____			
1 Steel 3 RMP (SR) <u>2 PVC</u> 4 ABS		5 Wrought iron 8 Concrete tile 6 Asbestos-Cement 9 Other (specify below) 7 Fiberglass			
Blank casing diameter <u>2</u> in. to _____ ft., Dia _____ in. to _____ ft., Dia _____ in. to _____ ft. Casing height above land surface <u>Flush</u> in., weight <u>703</u> lbs./ft. Wall thickness or gauge No. <u>154</u>					
TYPE OF SCREEN OR PERFORATION MATERIAL:		10 Asbestos-cement 11 Other (specify) _____ 1 Steel 3 Stainless steel 5 Fiberglass 8 RMP (SR) 2 Brass 4 Galvanized steel 6 Concrete tile 9 ABS 12 None used (open hole)			
SCREEN OR PERFORATION OPENINGS ARE:		5 Gauzed wrapped 8 Saw cut 11 None (open hole) 1 Continuous slot <u>3 Mill slot</u> 6 Wire wrapped 9 Drilled holes 2 Louvered shutter 4 Key punched 7 Torch cut 10 Other (specify) _____			
SCREEN-PERFORATED INTERVALS:		From <u>19.0</u> ft. to <u>39.0</u> ft., From _____ ft. to _____ ft. From _____ ft. to _____ ft., From _____ ft. to _____ ft. GRAVEL PACK INTERVALS: From <u>18.0</u> ft. to <u>39.0</u> ft., From _____ ft. to _____ ft. From _____ ft. to _____ ft., From _____ ft. to _____ ft.			
6 GROUT MATERIAL:		1 Neat cement 2 Cement grout <u>3 Bentonite</u> 4 Other _____			
Grout Intervals: From <u>18.0</u> ft. to <u>1.0</u> ft., From _____ ft. to _____ ft., From _____ ft. to _____ ft.					
What is the nearest source of possible contamination:		10 Livestock pens 14 Abandoned water well 1 Septic tank 4 Lateral lines 7 Pit privy <u>11 Fuel storage</u> 15 Oil well/Gas well 2 Sewer lines 5 Cess pool 8 Sewage lagoon 12 Fertilizer storage 16 Other (specify below) 3 Watertight sewer lines 6 Seepage pit 9 Feedyard 13 Insecticide storage			
Direction from well? <u>South</u>		How many feet? <u>40</u>			
FROM	TO	LITHOLOGIC LOG	FROM	TO	PLUGGING INTERVALS
<u>0.0</u>	<u>1.0</u>	<u>Concrete</u>			
<u>1.0</u>	<u>8.0</u>	<u>Fill sand w/ gravel size rock</u>			
<u>8.0</u>	<u>15.0</u>	<u>Silt, clayey</u>			
<u>15.0</u>	<u>25.0</u>	<u>Silt</u>			
<u>25.0</u>	<u>30.0</u>	<u>Silt</u>			
<u>30.0</u>	<u>39.0</u>	<u>Sand, fine to med. grain</u>			
<u>Flush Mount Waiver granted on 10-13-92</u> <u>for KDHE no. 06069495; Lenora Mercantile</u> <u>by Don Taylor</u>					
7 CONTRACTOR'S OR LANDOWNER'S CERTIFICATION: This water well was <u>(1) constructed</u> , (2) reconstructed, or (3) plugged under my jurisdiction and was completed on (mo/day/year) <u>11-17-92</u> and this record is true to the best of my knowledge and belief. Kansas Water Well Contractor's License No. <u>531</u> This Water Well Record was completed on (mo/day/yr) <u>11-25-92</u> under the business name of <u>GST</u> by (signature) <u>Allison Irwin</u>					