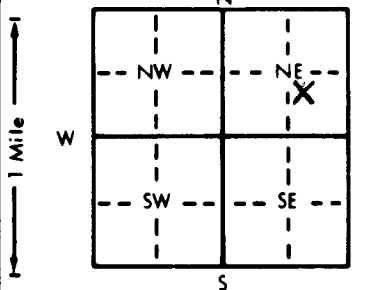


1 LOCATION OF WATER WELL: County: <u>Norton</u>		Fraction <u>NW</u> $\frac{1}{4}$ <u>SE</u> $\frac{1}{4}$ <u>NE</u> $\frac{1}{4}$		Section Number <u>28</u>	Township Number <u>T</u> <u>5</u> <u>S</u>		Range Number <u>R</u> <u>24</u> <u>E/W</u>	
Distance and direction from nearest town or city street address of well if located within city? <u>$\frac{1}{2}$ mile south, 1 mile west of Lenora</u>	
2 WATER WELL OWNER: <u>Glen Jones</u> RR#, St. Address, Box # : <u>Lenora, Kansas 67645</u> City, State, ZIP Code : _____ Board of Agriculture, Division of Water Resources Application Number: _____	
3 LOCATE WELL'S LOCATION WITH AN "X" IN SECTION BOX: <div style="text-align: center;"></div>			4 DEPTH OF COMPLETED WELL: <u>120</u> ft. ELEVATION: _____ ft. Depth(s) Groundwater Encountered 1. _____ ft. 2. _____ ft. 3. _____ ft. WELL'S STATIC WATER LEVEL <u>99</u> ft. below land surface measured on mo/day/yr _____ Pump test data: Well water was _____ ft. after _____ hours pumping _____ gpm Est. Yield _____ gpm: Well water was _____ ft. after _____ hours pumping _____ gpm Bore Hole Diameter <u>8</u> in. to <u>120</u> ft., and _____ in. to _____ ft. WELL WATER TO BE USED AS: 5 Public water supply 8 Air conditioning 11 Injection well 1 Domestic 3 Feedlot 6 Oil field water supply 9 Dewatering 12 Other (Specify below) _____ 2 Irrigation 4 Industrial 7 Lawn and garden only 10 Monitoring well _____ Was a chemical/bacteriological sample submitted to Department? Yes _____ No <u>X</u> _____; If yes, mo/day/yr sample was submitted _____ Water Well Disinfected? Yes _____ No <u>X</u> _____	
5 TYPE OF BLANK CASING USED: 1 Steel 3 RMP (SR) 5 Wrought iron 8 Concrete tile CASING JOINTS: Glued _____ Clamped _____ 2 PVC 4 ABS 6 Asbestos-Cement 9 Other (specify below) _____ Welded _____ 7 Fiberglass _____ Threaded _____ Blank casing diameter <u>4.5</u> in. to <u>100</u> ft. Dia. _____ in. to _____ ft. Dia. _____ in. to _____ ft. Casing height above land surface _____ in., weight <u>2.38</u> lbs./ft. Wall thickness or gauge No. <u>248</u> TYPE OF SCREEN OR PERFORATION MATERIAL: 7 PVC 10 Asbestos-cement 1 Steel 3 Stainless steel 5 Fiberglass 8 RMP (SR) 11 Other (specify) _____ 2 Brass 4 Galvanized steel 6 Concrete tile 9 ABS 12 None used (open hole) _____ SCREEN OR PERFORATION OPENINGS ARE: 5 Gauzed wrapped 8 Saw cut 11 None (open hole) 1 Continuous slot 3 Mill slot 6 Wire wrapped 9 Drilled holes 2 Louvered shutter 4 Key punched 7 Torch cut 10 Other (specify) _____ SCREEN-PERFORATED INTERVALS: From _____ ft. to _____ ft., From _____ ft. to _____ ft. From _____ ft. to _____ ft., From _____ ft. to _____ ft. GRAVEL PACK INTERVALS: From _____ ft. to _____ ft., From _____ ft. to _____ ft. From _____ ft. to _____ ft., From _____ ft. to _____ ft.	
6 GROUT MATERIAL: 1 Neat cement 2 Cement grout 3 Bentonite 4 Other _____ Grout Intervals: From <u>0</u> ft. to <u>20</u> ft., From _____ ft. to _____ ft., From _____ ft. to _____ ft. What is the nearest source of possible contamination: <u>NONE</u> 10 Livestock pens 14 Abandoned water well 1 Septic tank 4 Lateral lines 7 Pit privy 11 Fuel storage 15 Oil well/Gas well 2 Sewer lines 5 Cess pool 8 Sewage lagoon 12 Fertilizer storage 16 Other (specify below) _____ 3 Watertight sewer lines 6 Seepage pit 9 Feedyard 13 Insecticide storage _____ Direction from well? _____ How many feet? _____	
<table border="1" style="width:100%; border-collapse: collapse;"><thead><tr><th>FROM</th><th>TO</th><th>LITHOLOGIC LOG</th><th>FROM</th><th>TO</th><th>PLUGGING INTERVALS</th></tr></thead><tbody><tr><td>0</td><td>3</td><td>Surface</td><td></td><td></td><td></td></tr><tr><td>3</td><td>18</td><td>Silty Sand</td><td></td><td></td><td></td></tr><tr><td>18</td><td>29</td><td>Silty Sand</td><td></td><td></td><td></td></tr><tr><td>29</td><td>39</td><td>Fine Sand with Clay Strks.</td><td></td><td></td><td></td></tr><tr><td>39</td><td>40</td><td>Sandy Clay</td><td></td><td></td><td></td></tr><tr><td>40</td><td>60</td><td>Fine Sand and Clay</td><td></td><td></td><td></td></tr><tr><td>60</td><td>71</td><td>Fine Sand with Sandstone Strks.</td><td></td><td></td><td></td></tr><tr><td>71</td><td>76</td><td>Fine Sand with Clay Strks.</td><td></td><td></td><td></td></tr><tr><td>76</td><td>80</td><td>Fine Sand with Hard White Clay</td><td></td><td></td><td></td></tr><tr><td>80</td><td>91</td><td>Fine Sand</td><td></td><td></td><td></td></tr><tr><td>91</td><td>99</td><td>Sandstone & Fine Sand</td><td></td><td></td><td></td></tr><tr><td>99</td><td>100</td><td>Med. Loose Sand</td><td></td><td></td><td></td></tr><tr><td>100</td><td>114</td><td>Med. Sand</td><td></td><td></td><td></td></tr><tr><td>114</td><td>116</td><td>Hard White Stuff-Caliche</td><td></td><td></td><td></td></tr><tr><td>116</td><td>120</td><td>Red Bed & Ochre Bottom</td><td></td><td></td><td></td></tr>
7 CONTRACTOR'S OR LANDOWNER'S CERTIFICATION: This water well was (1) <u>constructed</u> , (2) reconstructed, or (3) plugged under my jurisdiction and was completed on (mo/day/year) <u>7-9-92</u> and this record is true to the best of my knowledge and belief. Kansas Water Well Contractor's License No. <u>554</u> This Water Well Record was completed on (mo/day/yr) <u>7-9-92</u> under the business name of <u>WOOFER PUMP & WELL, INC.</u> by (signature) <u>Gay Wright</u>	