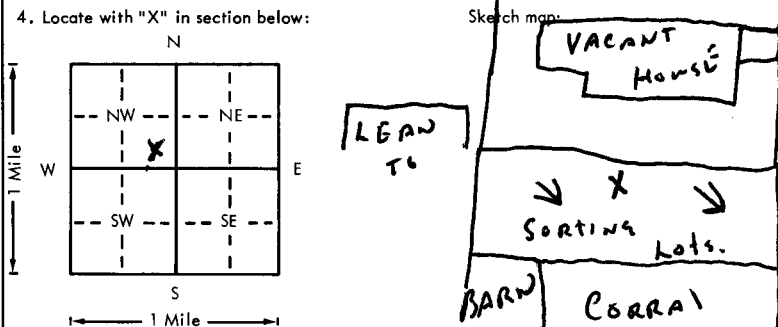


USE TYPEWRITER OR BALL
POINT PEN-PRESS FIRMLY,
PRINT CLEARLY.

KANONAH 103
BIDIS

WATER WELL RECORD
KSA 82a-1201-1215

Kansas Department of Health and
Environment-Division of Environment
(Water well Contractors)
Topeka, Kansas 66620

1. Location of well:		County Norton	Fraction SE 1/4 SE 1/4 NW 1/4	Section number 1	Township number T 5 S	Range number R 25 E/W
2. Distance and direction from nearest town or city: 4 miles Northeast of Street address of well location if in city: NEW ALMILLO KS				3. Owner of well: ELBERT GOLDSBY R.R. or street: City, state, zip code: NORTON KS 67654		
4. Locate with "X" in section below: <div></div>		6. Bore hole dia. 9 in. Completion date 3-3-77 Well depth 50 ft.				
5. Type and color of material		7. <input checked="" type="checkbox"/> Cable tool <input checked="" type="checkbox"/> Rotary <input type="checkbox"/> Driven <input type="checkbox"/> Dug <input type="checkbox"/> Hollow rod <input type="checkbox"/> Jetted <input type="checkbox"/> Bored <input type="checkbox"/> Reverse rotary				
		8. Use: <input type="checkbox"/> Domestic <input type="checkbox"/> Public supply <input type="checkbox"/> Industry <input type="checkbox"/> Irrigation <input type="checkbox"/> Air conditioning <input checked="" type="checkbox"/> Stock <input type="checkbox"/> Lawn <input type="checkbox"/> Oil field water <input type="checkbox"/> Other				
		9. Casing: Material <input type="checkbox"/> Height <input checked="" type="checkbox"/> Above or below Threaded <input type="checkbox"/> Welded <input type="checkbox"/> Surface 72 in. RMP <input type="checkbox"/> PVC <input checked="" type="checkbox"/> Weight 275 lbs./ft. Dia. 5 in. to 30 ft. depth Wall Thickness: inches or Dia. <input type="checkbox"/> in. to <input type="checkbox"/> ft. depth Gauge No. 230				
		10. Screen: Manufacturer's name MODERN PIPES INC Type PVC Dia. 5 Slot gauze 0.90 Length 20 Set between 30 ft. and 50 ft. Gravel pack? YES Size range of material 1/8-1/4				
		11. Static water level: <input type="checkbox"/> mo./day/yr. 23 ft. below land surface Date 10/25/76				
(Use a second sheet if needed)		12. Pumping level below land surfaces: ____ ft. after ____ hrs. pumping ____ g.p.m. ____ ft. after ____ hrs. pumping ____ g.p.m. Estimated maximum yield 10 g.p.m.				
		13. Water sample submitted: <input type="checkbox"/> Yes <input checked="" type="checkbox"/> No Date				
		14. Well head completion: <input checked="" type="checkbox"/> Pitless adapter 12 inches above grade				
		15. Well grouted? YES With: <input type="checkbox"/> Neat cement <input checked="" type="checkbox"/> Bentonite <input type="checkbox"/> Concrete Depth: From 0 ft. to 15 ft. MHC				
		16. Nearest source of possible contamination: CATTLE ft. 150 Direction S Type PENS Well disinfected upon completion? <input checked="" type="checkbox"/> Yes <input type="checkbox"/> No				
18. Elevation: Topography: <input type="checkbox"/> Hill <input checked="" type="checkbox"/> Slope <input type="checkbox"/> Upland <input type="checkbox"/> Valley		17. Pump: ____ Not installed Manufacturer's name AERMAISON Model number 505 HP 1/2 Volts 230 Length of drop pipe 39 ft. capacity 5 g.p.m. Type: <input checked="" type="checkbox"/> Submersible <input type="checkbox"/> Turbine <input type="checkbox"/> Jet <input type="checkbox"/> Reciprocating <input type="checkbox"/> Centrifugal <input type="checkbox"/> Other				
		20. Water well contractor's certification: This well was drilled under my jurisdiction and this report is true to the best of my knowledge and belief. Lawrence Drilling 167 Business name Box 148 Norton KS License No. Address Signed [Signature] Date 3-11-77 Authorized representative				
		19. Remarks: 2425 (TOPO)				