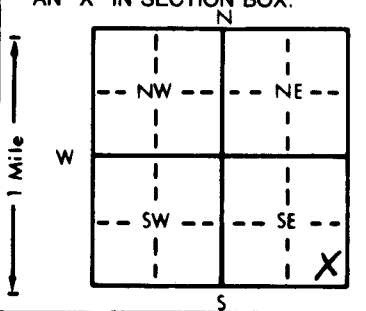


|                           |                      |                |                 |              |
|---------------------------|----------------------|----------------|-----------------|--------------|
| 1 LOCATION OF WATER WELL: | Fraction             | Section Number | Township Number | Range Number |
| County: Norton            | SE 1/4 SE 1/4 SE 1/4 | 9              | T 5 S           | R 25 EW      |

Distance and direction from nearest town or city street address of well if located within city?

1 Mile North, 1 1/2 mile West of New Almelo

|                                           |                                                   |
|-------------------------------------------|---------------------------------------------------|
| 2 WATER WELL OWNER: Caroline Austerman    | Board of Agriculture, Division of Water Resources |
| RR#, St. Address, Box # : 110 E. Warsaw   | Application Number:                               |
| City, State, ZIP Code : Norton, Ks. 67654 |                                                   |

|                                                                                  |   |
|----------------------------------------------------------------------------------|---|
| 3 LOCATE WELL'S LOCATION WITH AN "X" IN SECTION BOX:                             | 4 DEPTH OF COMPLETED WELL: 176 ft. ELEVATION:                                                                   |
|  | Depth(s) Groundwater Encountered 1. ft. 2. ft. 3. ft.                                                           |
|                                                                                  | WELL'S STATIC WATER LEVEL 121 ft. below land surface measured on mo/day/yr                                      |
|                                                                                  | Pump test data: Well water was ft. after hours pumping gpm                                                      |
|                                                                                  | Est. Yield gpm: Well water was ft. after hours pumping gpm                                                      |
|                                                                                  | Bore Hole Diameter 8 in. to 1.76 ft., and in. to ft.                                                            |
|                                                                                  | WELL WATER TO BE USED AS:                                                                                       |
|                                                                                  | 5 Public water supply 8 Air conditioning 11 Injection well                                                      |
|                                                                                  | 1 Domestic 3 Feedlot 6 Oil field water supply 9 Dewatering 12 Other (Specify below)                             |
|                                                                                  | 2 Irrigation 4 Industrial 7 Lawn and garden only 10 Monitoring well                                             |
|                                                                                  | Was a chemical/bacteriological sample submitted to Department? Yes No X; If yes, mo/day/yr sample was submitted |
|                                                                                  | Water Well Disinfected? Yes No X                                                                                |

|                                                                                               |                    |                   |                                |
|-----------------------------------------------------------------------------------------------|--------------------|-------------------|--------------------------------|
| 5 TYPE OF BLANK CASING USED:                                                                  | 5 Wrought iron     | 8 Concrete tile   | CASING JOINTS: Glued X Clamped |
| 1 Steel                                                                                       | 3 RMP (SR)         | 6 Asbestos-Cement | 9 Other (specify below)        |
| 2 PVC                                                                                         | 4 ABS              | 7 Fiberglass      | 10 Asbestos-cement             |
| Blank casing diameter 4.5 in. to 136 ft., Dia                                                 |                    |                   | 11 Other (specify)             |
| Casing height above land surface 18 in., weight 2.38 lbs./ft. Wall thickness or gauge No. 248 |                    |                   | 12 None used (open hole)       |
| TYPE OF SCREEN OR PERFORATION MATERIAL:                                                       | 7 PVC              |                   |                                |
| 1 Steel                                                                                       | 3 Stainless steel  | 5 Fiberglass      | 8 RMP (SR)                     |
| 2 Brass                                                                                       | 4 Galvanized steel | 6 Concrete tile   | 9 ABS                          |
| SCREEN OR PERFORATION OPENINGS ARE:                                                           | 5 Gauzed wrapped   | 8 Saw cut         | 11 None (open hole)            |
| 1 Continuous slot                                                                             | 3 Mill slot        | 6 Wire wrapped    | 9 Drilled holes                |
| 2 Louvered shutter                                                                            | 4 Key punched      | 7 Torch cut       | 10 Other (specify)             |
| SCREEN-PERFORATED INTERVALS: From 136 ft. to 176 ft., From ft. to ft.                         |                    |                   |                                |
| GRAVEL PACK INTERVALS: From 20 ft. to 176 ft., From ft. to ft.                                |                    |                   |                                |

|                                                                         |                   |                         |                        |                          |
|-------------------------------------------------------------------------|-------------------|-------------------------|------------------------|--------------------------|
| 6 GROUT MATERIAL:                                                       | 1 Neat cement     | 2 Cement grout          | 3 Bentonite            | 4 Other                  |
| Grout Intervals: From 0 ft. to 20 ft., From ft. to ft., From ft. to ft. |                   |                         |                        |                          |
| What is the nearest source of possible contamination:                   | 10 Livestock pens | 14 Abandoned water well |                        |                          |
| 1 Septic tank                                                           | 4 Lateral lines   | 7 Pit privy             | 11 Fuel storage        | 15 Oil well/Gas well     |
| 2 Sewer lines                                                           | 5 Cess pool       | 8 Sewage lagoon         | 12 Fertilizer storage  | 16 Other (specify below) |
| 3 Watertight sewer lines                                                | 6 Seepage pit     | 9 Feedyard              | 13 Insecticide storage |                          |
| Direction from well?                                                    |                   | How many feet?          |                        |                          |

| FROM | TO  | LITHOLOGIC LOG                            | FROM | TO  | PLUGGING INTERVALS                        |
|------|-----|-------------------------------------------|------|-----|-------------------------------------------|
| 0    | 2   | Surface                                   | 120  | 124 | Fine Med. Sand                            |
| 2    | 15  | Loess                                     | 124  | 142 | Tight Sand w/Clay Strks.                  |
| 15   | 21  | Clay                                      | 142  | 145 | Sandy Clay w/Fine Sand                    |
| 21   | 28  | Clay & Caliche Strks.                     | 145  | 156 | Sandy Clay                                |
| 28   | 42  | Cemented Sand w/Caliche Strks.            | 156  | 176 | Fine to Med. Sand w/Clay & Caliche Strks. |
| 42   | 50  | Cemented Sand w/Fine Sand                 |      |     |                                           |
| 50   | 70  | Cemented Sand & Caliche w/ some Fine Sand | 176  |     | Ochre                                     |
| 70   | 78  | Cemented Sand w/Caliche                   |      |     |                                           |
| 78   | 85  | Cemented Sand, Caliche w/ Clay Layers     |      |     |                                           |
| 85   | 100 | Cemented Sand w/Fine Sand & Clay          |      |     |                                           |
| 100  | 107 | Fine Med. Sand w/Caliche Strks.           |      |     |                                           |
| 107  | 117 | Cemented Sand w/Clay Strks.               |      |     |                                           |
| 117  | 120 | Tight Sand w/Caliche Strks.               |      |     |                                           |

|   |
|---|
| 7 CONTRACTOR'S OR LANDOWNER'S CERTIFICATION: This water well was (1) constructed, (2) reconstructed, or (3) plugged under my jurisdiction and was completed on (mo/day/year) 3-22-94 and this record is true to the best of my knowledge and belief. Kansas Water Well Contractor's License No. 554 This Water Well Record was completed on (mo/day/yr) 3-24-94 under the business name of Woofter Pump & Well, Inc. by (signature) Gary C. Woofter |
|---|