

WATER WELL PLUGGING RECORD Form WWC-5P
KSA 82a-1212
ID NO.

1 LOCATION OF WATER WELL: County: Norton	Fraction $\frac{1}{4}$ nw $\frac{1}{4}$ se $\frac{1}{4}$ nw $\frac{1}{4}$	Section Number 24	Township Number T 5 S	Range Number 25 <input type="checkbox"/> E <input checked="" type="checkbox"/> W
--	--	----------------------	--------------------------	---

Street/Rural Address of Well Location; if unknown, distance & direction from nearest town or intersection: If at owner's address, check here ☐ Int. of Co Rd BB & Co Rd W11...1649' S 1441' E

Global Positioning Systems (GPS) information:

Latitude: 39.605833 (in decimal degrees)

Longitude: 100.091700 (in decimal degrees)

Elevation:

 Horizontal Datum: ☐ WGS84, ☐ NAD83, ☒ NAD27

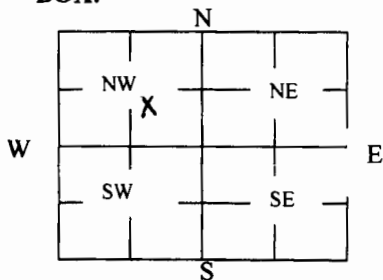
Collection Method:

☒ GPS unit (Make/Model: Garmin Montana 650T)

☒ Digital Map/Photo, ☐ Topographic Map, ☐ Land Survey

 Est. Accuracy: ☒ < 3 m, ☐ 3-5 m, ☐ 5-15 m, ☐ > 15 m

2 WATER WELL OWNER: Hickert Farms, Inc.
RR#, St. Address, Box #: 2905 Crystal Aire Ct.
City, State ZIP Code: Grain Valley, MO 64029

3 MARK WELL'S LOCATION WITH AN "X" IN SECTION BOX:

4 DEPTH OF WELL 94 ft.

WELL'S STATIC WATER LEVEL 69 ft

WELL WAS USED AS:

☒ Domestic
☐ Irrigation
☐ Feedlot
☐ Industrial

☐ Public Water Supply
☐ Oil Field Water Supply
☐ Domestic (Lawn & Garden)
☐ Air Conditioning

☐ Dewatering
☐ Monitoring
☐ Injection Well
☐ Other

 Was a chemical/bacteriological sample submitted to Department? Yes ☐ No ☒
5 TYPE OF BLANK CASING USED:
☒ Steel
☐ PVC

☐ RMP (SR)
☐ ABS

☐ Wrought
☐ Asbestos-Cement

☐ Fiberglass
☐ Concrete Tile

☐ Other (Specify below)

 Blank casing diameter 6 in. Was casing pulled? Yes ☒ No ☐ If yes, how much 3'
Casing height above or below land surface -36 in.

6 GROUT PLUG MATERIAL: ☐ Neat cement ☐ Cement grout ☒ Bentonite ☐ Other

Grout Plug Intervals: From 3 ft. to 6 ft., From 66 ft. to 69 ft., From ft. to ft.

What is the nearest source of possible contamination:

☐ Septic tank
☐ Sewer lines
☐ Watertight sewer lines
☐ Lateral lines
☐ Cess pool

☐ Seepage pit
☐ Pit privy
☐ Sewage lagoon
☐ Feedyard
☐ Livestock pens

☐ Fuel storage
☐ Fertilizer storage
☐ Insecticide storage
☐ Abandoned water well
☐ Oil well/Gas well

☒ Other (specify below)
NONE

 Direction from well? _____
How many feet? _____

FROM	TO	PLUGGING MATERIALS	FROM	TO	PLUGGING MATERIALS
0	3	Soil			
3	6	Bentonite			
6	66	Native Clay			
66	69	Bentonite			
69	94	Chlorinated Sand			

7 CONTRACTOR'S OR LANDOWNER'S CERTIFICATION: This water well was plugged under my jurisdiction and was completed on (mo/day/year) 3-8-17 and this record is true to the best of my knowledge and belief. Kansas Water Well Contractor's License No. 838. This Water Well Record was completed on (mo/day/year) 3-26-17 under the business name of RMD Drilling & Well Service, LLC by (signature) *D. S. S. S.*

Send one white copy to Kansas Department of Health & Environment, Geology Section, 1000 SW Jackson Street, Ste. 420, Topeka, KS 66612-1367. Send one copy to WATER WELL OWNER and retain one for your records.

Visit us at <http://www.kdheks.gov/waterwell/index.html> Telephone 785-296-5524.

KSA82a-1212

Revised 1/20/2015