

USE TYPEWRITER OR BALL POINT PEN-PRESS FIRMLY, PRINT CLEARLY.


WATER WELL RECORD
KSA 82a-1201-1215

Kansas Department of Health and Environment-Division of Environment (Water well Contractors) Topeka, Kansas 66620

ADD

1. Location of well: County Decatur Fraction SW 1/4 SW 1/4 NE 1/4 Section number 21 Township number T 5 S R 26 Range number X/W

2. Distance and direction from nearest town or city: From Dresden, 3/4 East; 1 1/4 South
Street address of well location if in city:
3. Owner of well: Louis Randolph
R.R. or street:
City, state, zip code: Allison, Kansas

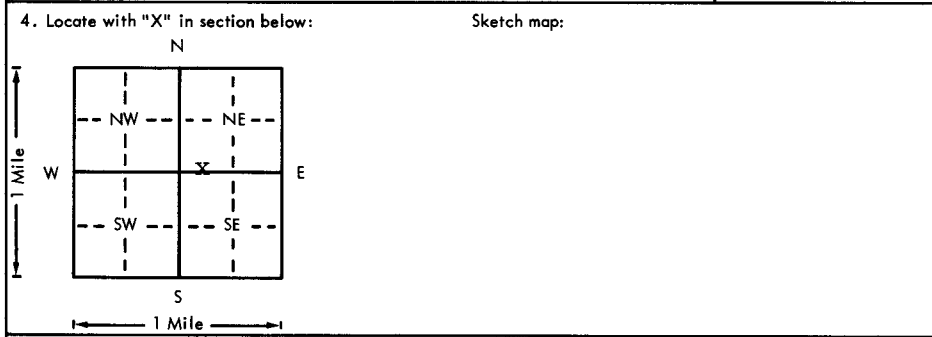

6. Bore hole dia. 30 in. Completion date 8-17-76
Well depth 211 ft.

7. Cable tool Rotary Driven Dug
 Hollow rod Jetted Bored Reverse rotary

8. Use: Domestic Public supply Industry
 Irrigation Air conditioning Stock
 Lawn Oil field water Other

9. Casing: Material Steel Height: Above or ~~Below~~
Threaded Welded Surface 12 in.
RMP PVC Weight .188 lbs./ft.
Dia. 16 in. to 141 ft. depth; Wall Thickness: inches
Dia. in. to ft. depth; gage No. #7

5. Type and color of material	From	To
Soil & Clay	0	25
Fine Sand & Clay	25	57
Rock	57	60
Clay & Limestone	60	100
Fine to Med. Sand	100	120
Rock	120	122
Fine to Med. Sand	122	141
Clay	141	178
Med. Sand	178	208
Yellow Clay	208	209
Shale	209	211
(Use a second sheet if needed)		

10. Screen: Manufacturer's name Brown
Type Perforated Dia. 16"
Slot/gauze 10% Length 60'
Set between 141 ft. and 201 ft.
10' Cook 201 ft. and 211 ft.

Gravel pack? Size range of material 1/4x5/8

11. Static water level: 148 ft. below land surface Date 8-19-76

12. Pumping level below land surfaces:
206 ft. after 2 hrs. pumping 521 g.p.m.
____ ft. after ____ hrs. pumping ____ g.p.m.
Estimated maximum yield 521 g.p.m.

13. Water sample submitted: X Yes No Date _____

14. Well head completion: 12 inches above grade
 Pitless adapter

15. Well grouted? Neat cement Bentonite Clay Concrete
Depth: From 0 ft. to 10 ft.

16. Nearest source of possible contamination:
ft. 374M Direction SW Type Farm
Well disinfected upon completion? Yes No

17. Pump: Not installed
Manufacturer's name Floway
Model number 056147 HP 75 Volts 460
Length of drop pipe 210 ft. capacity 500 g.p.m.
Type: Submersible Turbine
 Jet Reciprocating
 Centrifugal Other

18. Elevation: Topography: Hill Slope Upland Valley

19. Remarks: BROCK 208'

20. Water well contractor's certification:
This well was drilled under my jurisdiction and this report is true to the best of my knowledge and belief.
Western Well & Pump 245
Business name License No. _____
Address: Box 852 Colby, KS 67701
Signed Jerry Berry Date _____
Authorized representative

1-5 260 2 L SE SW NE 1/4 1/4 1/4