USE TYPEWRITER OR BALL POINT PEN-PRESS FIRMLY, PRINT CLEARLY.

NEW ALMELO

WATER WELL RECORD
KSA 82a-1201-1215

DCB

Kansas Department of Health and Environment-Division of Environment
(Water well Contractors)
Topeka, Kansas 66620

1. Location of well:	County	Fraction	Section number	Township number	Range number
	Decatur	NW 1/4 SW 1/4 SE 1/4	25	T 5 S	R 26 E (W)

2. Distance and direction from nearest town or city: 4½ W ¾ S of New Almelo
Street address of well location if in city:

3. Owner of well: John George Isaserman
R.R. or street:
City, state, zip code: Clayton, Ks

4. Locate with "X" in section below: Sketch map:

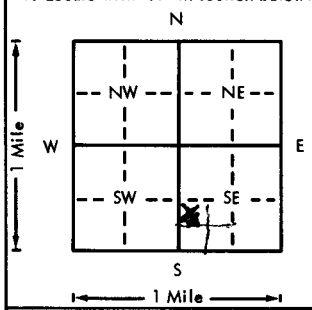

6. Bore hole dia. 27 in. Completion date 5-23-75
Well depth 55 ft.

7. (X) Cable tool ( ) Rotary ( ) Driven ( ) Dug
( ) Hollow rod ( ) Jetted ( ) Bored ( ) Reverse rotary

8. Use: ( ) Domestic ( ) Public supply ( ) Industry
(X) Irrigation ( ) Air conditioning ( ) Stock
( ) Lawn ( ) Oil field water ( ) Other

9. Casing: Material Asb-C Height: (Above) or below
Threaded ____ Welded ____ Surface 8 in.
RMP ____ PVC ____ Weight 38.46 lbs./ft.
Dia. 16 in. to 29 ft. depth Wall Thickness: inches or
Dia. ____ in. to ____ ft. depth gage No. 3/8

5. Type and color of material	From	To
Top soil	0	20
sand & Gravel	20	56
shale	56	57

10. Screen: Manufacturer's name John Maxwell
Type Asb-C Dia. 16
Slot (gauze) 78 Length 26
Set between 29 ft. and 55 ft.
____ ft. and ____ ft.
Gravel pack? ~~yes~~ Size range of material 1/4

11. Static water level: mo./day/yr.
29 ft. below land surface Date 5-23-75

12. Pumping level below land surfaces:
38 ft. after 6 hrs. pumping 400 g.p.m.
____ ft. after ____ hrs. pumping ____ g.p.m.
Estimated maximum yield 600 g.p.m.

13. Water sample submitted: mo./day/yr.
( ) Yes (X) No Date ____

14. Well head completion:
( ) Pitless adapter 8 Inches above grade

15. Well grouted? yes
With: ( ) Neat cement (X) Bentonite ( ) Concrete
Depth: From 0 ft. to 10 ft.

16. Nearest source of possible contamination:
ft. 24 m Direction S Type River
Well disinfected upon completion? (X) Yes ( ) No

17. Pump: ( ) Not installed
Manufacturer's name Western Land Roller
Model number Turbine HP 25 Volts 440
Length of drop pipe 50 ft. capacity 600 g.p.m.
Type:
( ) Submersible (X) Turbine
( ) Jet ( ) Reciprocating
( ) Centrifugal ( ) Other

(Use a second sheet if needed)

18. Elevation:
Topography:
( ) Hill
(X) Slope
( ) Upland
( ) Valley

19. Remarks:
2436' (TOPO)

20. Water well contractor's certification:
This well was drilled under my jurisdiction and this report is true to the best of my knowledge and belief.
Corder Drilling 114
Business name License No.
Address Selden, Ks
Signed Elmer Corder Date 12-02-75
Authorized representative

T 5 R 26 E (W) Sec 25 1/4 NW 1/4 SW 1/4 NE 1/4

Forward the white, blue and pink copies to the Department of Health and Environment

Form WWC-5