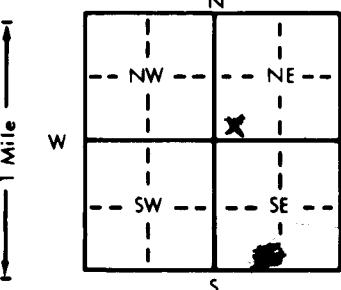


1 LOCATION OF WATER WELL:		Fraction	Section Number	Township Number	Range Number
County: DECATUR		SW 1/4 SW 1/4 NE 1/4	35	T 5 S	R 26 EW
Distance and direction from nearest town or city street address of well if located within city? 11 1/2 West & 1 1/2 South of Lenora, KS--then curve around a lane E & N.					
2 WATER WELL OWNER: MRS. LOIS SCOTT RR#, St. Address, Box #: HC 01, Box 30 City, State, ZIP Code: JENNINGS, KS 67643 Board of Agriculture, Division of Water Resources Application Number: 39,640					
3 LOCATE WELL'S LOCATION WITH AN "X" IN SECTION BOX:		4 DEPTH OF COMPLETED WELL: 47 ft. ELEVATION:			
		Depth(s) Groundwater Encountered 1. 20 ft. 2. ft. 3. ft. WELL'S STATIC WATER LEVEL 20 ft. below land surface measured on mo/day/yr 6/14/89 Pump test data: Well water was ft. after hours pumping gpm Est. Yield gpm: Well water was ft. after hours pumping gpm Bore Hole Diameter in. to ft., and in. to ft. WELL WATER USED AS: 5 Public water supply 8 Air conditioning 11 Injection well 1 Domestic 3 Feedlot 6 Oil field water supply 9 Dewatering 12 Other (Specify below) 2 Irrigation 4 Industrial 7 Lawn and garden only 10 Monitoring well Was a chemical/bacteriological sample submitted to Department? Yes No; If yes, mo/day/yr sample was submitted Water Well Disinfected? Yes No			
5 TYPE OF BLANK CASING USED: 1 Steel 3 RMP (SR) 5 Wrought iron 8 Concrete tile CASING JOINTS: Glued Clamped 2 PVC 4 ABS 6 Asbestos-Cement 9 Other (specify below) Welded 7 Fiberglass Threaded Blank casing diameter 18 in. to ft., Dia in. to ft., Dia in. to ft. Casing height 44 ft. below land surface. Ft. below in., weight lbs./ft. Wall thickness or gauge No. TYPE OF SCREEN OR PERFORATION MATERIAL: 7 PVC 10 Asbestos-cement 1 Steel 3 Stainless steel 5 Fiberglass 8 RMP (SR) 11 Other (specify) 2 Brass 4 Galvanized steel 6 Concrete tile 9 ABS 12 None used (open hole) SCREEN OR PERFORATION OPENINGS ARE: 5 Gauzed wrapped 8 Saw cut 11 None (open hole) 1 Continuous slot 3 Mill slot 6 Wire wrapped 9 Drilled holes 2 Louvered shutter 4 Key punched 7 Torch cut 10 Other (specify) SCREEN-PERFORATED INTERVALS: From ft. to ft., From ft. to ft., From ft. to ft. GRAVEL PACK INTERVALS: From ft. to ft., From ft. to ft., From ft. to ft.					
6 GROUT MATERIAL: 1 Neat cement 2 Cement grout 3 Bentonite 4 Other Vol Plug Grout intervals: From 6 ft. to 3 ft., From ft. to ft., From ft. to ft. What is the nearest source of possible contamination: 10 Livestock pens 14 Abandoned water well 1 Septic tank 4 Lateral lines 7 Pit privy 11 Fuel storage 15 Oil well/Gas well 2 Sewer lines 5 Cess pool 8 Sewage lagoon 12 Fertilizer storage 16 Other (specify below) 3 Watertight sewer lines 6 Seepage pit 9 Feedyard 13 Insecticide storage nothing Direction from well? How many feet?					
FROM	TO	LITHOLOGIC LOG	FROM	TO	PLUGGING INTERVALS
47	20	Sand and gravel (47.7 cu. ft.)			
20	6	Clay (24.74 cu. ft.)			
6	3	Vol Plug (5.3 cu. ft.)			
3	0+1	Dirt			
7 CONTRACTOR'S OR LANDOWNER'S CERTIFICATION: This water well was (1) constructed, (2) reconstructed, or (3) plugged under my jurisdiction and was completed on (mo/day/year) Dec. 8, 1989 and this record is true to the best of my knowledge and belief. Kansas Water Well Contractor's License No. This Water Well Record was completed on (mo/day/yr) 12-11-89 under the business name of by (signature) Lois Scott					
INSTRUCTIONS: Use typewriter or ball point pen. PLEASE PRESS FIRMLY and PRINT clearly. Please fill in blanks, underline or circle the correct answers. Send top three copies to Kansas Department of Health and Environment, Bureau of Water Protection, Topeka, Kansas 66620-7320. Telephone: 913-296-5514. Send one to WATER WELL OWNER and retain one for your records.					