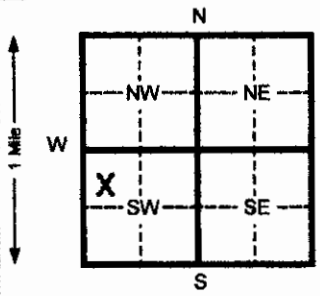


1 LOCATION OF WATER WELL:		Fraction	Section Number		Township Number		Range Number	
County: Decatur		SW $\frac{1}{4}$ NW $\frac{1}{4}$ SW $\frac{1}{4}$	23		T 5 S		R 26 SW	
Distance and direction from nearest town or city street address of well if located within city?								
2 WATER WELL OWNER: Kay Reedy								
RR#, St. Address, Box #: 1416 Utah Ave Board of Agriculture, Division of Water Resources								
City, State, ZIP Code: Hoxie, Ks 67740 Application Number: 20070182								
3 LOCATE WELL'S LOCATION WITH AN "X" IN SECTION BOX:			4 DEPTH OF COMPLETED WELL 150 ft. ELEVATION:					
			Depth(s) Groundwater Encountered 1 _____ ft. 2 _____ ft. 3 _____ ft.					
			WELL'S STATIC WATER LEVEL na ft. below land surface measured on mo/day/yr					
			Pump test data: Well water was _____ ft. after _____ hours pumping _____ gpm					
			Est. Yield _____ gpm: Well water was _____ ft. after _____ hours pumping _____ gpm					
			Bore Hole Diameter 8 in. to 160 ft. and _____ in. to _____ ft.					
			WELL WATER TO BE USED AS: 5 Public water supply 8 Air conditioning 11 Injection well					
			1 Domestic 3 Feed lot 6 Oil field water supply 9 Dewatering 12 Other (Specify below)					
			2 Irrigation 4 Industrial 7 Lawn and garden (domestic) 10 Monitoring well					
			Was a chemical/bacteriological sample submitted to Department? Yes _____ No X If yes, mo/day/yr sample was submitted _____					
			Water Well Disinfected? Yes X No _____					
5 TYPE OF BLANK CASING USED:								
1 Steel			3 RMP (SR)			5 Wrought Iron		
2 PVC			4 ABS			8 Concrete tile		
			7 Fiberglass			CASING JOINTS: Glued X Clamped _____		
						Welded _____		
						Threaded _____		
Blank casing diameter 4.5 in. to 110 ft., Dia _____ in. to _____ ft., Dia _____ in. to _____ ft.								
Casing height above land surface 18 in., weight 2.38 lbs./ft. Wall thickness or gauge No. _____								
TYPE OF SCREEN OR PERFORATION MATERIAL:								
1 Steel			3 Stainless steel			5 Fiberglass		
2 Brass			4 Galvanized steel			8 RMP (SR)		
			6 Concrete tile			9 ABS		
						10 Asbestos-cement		
						11 Other (specify) _____		
						12 None used (open hole)		
SCREEN OR PERFORATION OPENINGS ARE:								
1 Continuous slot			3 Mill slot			5 Gauzed wrapped		
2 Louvered shutter			4 Key punched			8 Saw cut		
						11 None (open hole)		
						9 Drilled holes		
						10 Other (specify) _____		
SCREEN-PERFORATED INTERVALS:								
From 110 ft. to 150 ft.			From _____ ft. to _____ ft.			From _____ ft. to _____ ft.		
From _____ ft. to _____ ft.			From _____ ft. to _____ ft.			From _____ ft. to _____ ft.		
From _____ ft. to _____ ft.			From _____ ft. to _____ ft.			From _____ ft. to _____ ft.		
GRAVEL PACK INTERVALS:								
From 20 ft. to 150 ft.			From _____ ft. to _____ ft.			From _____ ft. to _____ ft.		
From _____ ft. to _____ ft.			From _____ ft. to _____ ft.			From _____ ft. to _____ ft.		
From _____ ft. to _____ ft.			From _____ ft. to _____ ft.			From _____ ft. to _____ ft.		
6 GROUT MATERIAL:								
1 Neat cement			2 Cement grout			3 Bentonite		
4 Other _____								
Grout intervals From 0 ft. to 20 ft. From _____ ft. to _____ ft. From _____ ft. to _____ ft.								
What is the nearest source of possible contamination:								
1 Septic tank			4 Lateral lines			7 Pit privy		
2 Sewer lines			5 Cess pool			8 Sewage lagoon		
3 Watertight sewer lines			6 Seepage pit			9 Feedyard		
						10 Livestock pens		
						11 Fuel storage		
						12 Fertilizer storage		
						13 Insecticide storage		
						14 Abandoned water well		
						15 Oil well/ Gas well		
						16 Other (specify below) none		
Direction from well? _____ How many feet? _____								
7 CONTRACTOR'S OR LANDOWNER'S CERTIFICATION: This water well was (1) constructed, (2) reconstructed, or (3) plugged under my jurisdiction and was completed on (mo/day/yr) 5-31-07 and this record is true to the best of my knowledge and belief. Kansas								
Water Well Contractor's License No. 554 This Water Well Record was completed on (mo/day/yr) 6-1-07								
under the business name of Woofert Pump & Well Inc. by (signature) <i>[Signature]</i>								
INSTRUCTIONS: Please fill in blanks and circle the correct answers. Send three copies to Kansas Department of Health and Environment, Bureau of Water, 1000 S W Jackson St., Ste. 420, Topeka, Kansas 66612-1387. Telephone: 913-298-5545. Send one to WATER WELL OWNER and retain one for your records.								