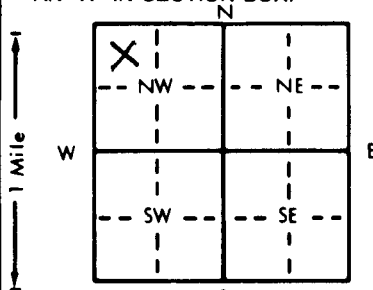


|                           |                                                                        |                |                            |                              |
|---------------------------|------------------------------------------------------------------------|----------------|----------------------------|------------------------------|
| 1 LOCATION OF WATER WELL: | Fraction                                                               | Section Number | Township Number            | Range Number                 |
| County: <u>Decatur</u>    | <u>C</u> $\frac{1}{4}$ <u>NW</u> $\frac{1}{4}$ <u>NW</u> $\frac{1}{4}$ | <u>29</u>      | <u>T</u> <u>5</u> <u>S</u> | <u>R</u> <u>27</u> <u>EW</u> |

Distance and direction from nearest town or city street address of well if located within city?

|                                                  |                                                   |
|--------------------------------------------------|---------------------------------------------------|
| 2 WATER WELL OWNER: <u>Dean Gawith</u>           | Board of Agriculture, Division of Water Resources |
| RR#, St. Address, Box # :                        | Application Number:                               |
| City, State, ZIP Code : <u>Dresden, KS 67635</u> |                                                   |

|                                                                                  |   |
|----------------------------------------------------------------------------------|---|
| 3 LOCATE WELL'S LOCATION WITH AN "X" IN SECTION BOX:                             | 4 DEPTH OF COMPLETED WELL: <u>160</u> ft. ELEVATION:                                                                              |
|  | Depth(s) Groundwater Encountered 1. .... ft. 2. .... ft. 3. .... ft.                                                              |
|                                                                                  | WELL'S STATIC WATER LEVEL <u>81</u> ft. below land surface measured on mo/day/yr                                                  |
|                                                                                  | Pump test data: Well water was .... ft. after .... hours pumping .... gpm                                                         |
|                                                                                  | Est. Yield .... gpm: Well water was .... ft. after .... hours pumping .... gpm                                                    |
|                                                                                  | Bore Hole Diameter <u>8</u> in. to <u>160</u> ft., and .... in. to .... ft.                                                       |
|                                                                                  | WELL WATER TO BE USED AS:   |
|                                                                                  | 1 Domestic 3 Feedlot 6 Oil field water supply 9 Dewatering 12 Other (Specify below)                                               |
|                                                                                  | 2 Irrigation 4 Industrial 7 Lawn and garden only 10 Monitoring well                                                               |
|                                                                                  | Was a chemical/bacteriological sample submitted to Department? Yes ..... No <u>X</u> ..... If yes, mo/day/yr sample was submitted |
|                                                                                  | Water Well Disinfected? Yes <u>X</u> No                                                                                           |

|   |                                       |                           |                                       |
|---|---------------------------------------|---------------------------|---------------------------------------|
| 5 TYPE OF BLANK CASING USED:                                                                                       | 5 Wrought iron                        | 8 Concrete tile           | CASING JOINTS: Glued <u>X</u> Clamped |
| 1 Steel   | 3 RMP (SR)                            | 6 Asbestos-Cement         | 9 Other (specify below)               |
| 2 PVC   | 4 ABS                                 | 7 Fiberglass              | 10 Asbestos-cement                    |
| Blank casing diameter <u>5</u> in. to <u>140</u> ft., Dia                                                          |                                       |                           |                                       |
| Casing height above land surface <u>18</u> in., weight <u>2.38</u> lbs./ft. Wall thickness or gauge No. <u>248</u> |                                       |                           |                                       |
| TYPE OF SCREEN OR PERFORATION MATERIAL:                                                                            | 7 PVC                                 | 10 Asbestos-cement        |                                       |
| 1 Steel   | 3 Stainless steel                     | 5 Fiberglass              | 8 RMP (SR)                            |
| 2 Brass   | 4 Galvanized steel                    | 6 Concrete tile           | 9 ABS                                 |
| SCREEN OR PERFORATION OPENINGS ARE:                                                                                | 5 Gauzed wrapped                      | 8 Saw cut                 | 11 None (open hole)                   |
| 1 Continuous slot                                                                                                  | 3 Mill slot                           | 6 Wire wrapped            | 9 Drilled holes                       |
| 2 Louvered shutter                                                                                                 | 4 Key punched                         | 7 Torch cut               | 10 Other (specify)                    |
| SCREEN-PERFORATED INTERVALS:                                                                                       | From <u>140</u> ft. to <u>160</u> ft. | From .... ft. to .... ft. |                                       |
|   | From .... ft. to .... ft.             | From .... ft. to .... ft. |                                       |
| GRAVEL PACK INTERVALS:                                                                                             | From <u>20</u> ft. to <u>160</u> ft.  | From .... ft. to .... ft. |                                       |
|   | From .... ft. to .... ft.             | From .... ft. to .... ft. |                                       |

|                                                       |                                    |                           |                           |                           |
|-------------------------------------------------------|------------------------------------|---------------------------|---------------------------|---------------------------|
| 6 GROUT MATERIAL:                                     | 1 Neat cement                      | 2 Cement grout            | 3 Bentonite               | 4 Other                   |
| GROUT INTERVALS:                                      | From <u>0</u> ft. to <u>20</u> ft. | From .... ft. to .... ft. | From .... ft. to .... ft. | From .... ft. to .... ft. |
| What is the nearest source of possible contamination: | 1 Septic tank                      | 4 Lateral lines           | 7 Pit privy               | 10 Livestock pens         |
|                                                       | 2 Sewer lines                      | 5 Cess pool               | 8 Sewage lagoon           | 11 Fuel storage           |
|                                                       | 3 Watertight sewer lines           | 6 Seepage pit             | 9 Feedyard                | 12 Fertilizer storage     |
|                                                       |                                    |                           |                           | 13 Insecticide storage    |
|                                                       |                                    |                           |                           | 14 Abandoned water well   |
|                                                       |                                    |                           |                           | 15 Oil well/Gas well      |
|                                                       |                                    |                           |                           | 16 Other (specify below)  |
|                                                       |                                    |                           |                           | <u>NONE</u>               |
| Direction from well?                                  |                                    |                           |                           | How many feet?            |

| FROM | TO  | LITHOLOGIC LOG                         | FROM | TO | PLUGGING INTERVALS |
|------|-----|----------------------------------------|------|----|--------------------|
| 0    | 2   | surface                                |      |    |                    |
| 2    | 20  | loess                                  |      |    |                    |
| 20   | 31  | clay & caliche                         |      |    |                    |
| 31   | 56  | sandy clay & caliche                   |      |    |                    |
| 56   | 66  | cemented sand w/ clay & sand           |      |    |                    |
| 66   | 80  | sandy clay w/ cemented & med sand stks |      |    |                    |
| 80   | 89  | med sand w/ few clay layers            |      |    |                    |
| 89   | 100 | sandy clay w/ few sand stks            |      |    |                    |
| 100  | 115 | sandy clay & fine sand mix             |      |    |                    |
| 115  | 133 | sticky sand clay w/ some sand          |      |    |                    |
| 133  | 146 | fine sand w/ clay stks                 |      |    |                    |
| 146  | 155 | orchre                                 |      |    |                    |
| 155  | 160 | shale                                  |      |    |                    |

|   |
|---|
| 7 CONTRACTOR'S OR LANDOWNER'S CERTIFICATION: This water well was (1) constructed, (2) reconstructed, or (3) plugged under my jurisdiction and was completed on (mo/day/year) <u>8-8-96</u> and this record is true to the best of my knowledge and belief. Kansas Water Well Contractor's License No. <u>554</u> This Water Well Record was completed on (mo/day/yr) <u>8-20-96</u> under the business name of <u>Woofter Pump &amp; well, Inc.</u> by (signature) <u>[Signature]</u> |
|---|