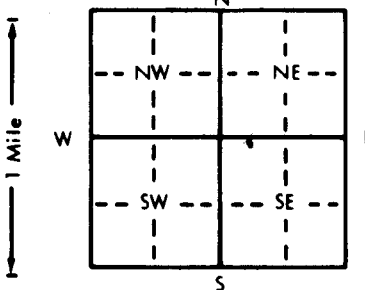


1 LOCATION OF WATER WELL:		Fraction	Section Number	Township Number	Range Number
County: Decatur		NW 1/4 NW 1/4 SE 1/4	2	T 5 S	R 28 EW
Distance and direction from nearest town or city street address of well if located within city? 2 mi. north and 1/2 mi. west of Dresden, Kansas					
2 WATER WELL OWNER:					
RR#, St. Address, Box # : City, State, ZIP Code :			Sylvester Ritter Dresden, Kansas 67635 Board of Agriculture, Division of Water Resources Application Number:		
3 LOCATE WELL'S LOCATION WITH AN "X" IN SECTION BOX:		4 DEPTH OF COMPLETED WELL 76 ft. ELEVATION:			
		Depth(s) Groundwater Encountered 1. 45 ft. 2. ft. 3. ft.			
		WELL'S STATIC WATER LEVEL 45 ft. below land surface measured on mo/day/yr			
		Pump test data: Well water was ft. after hours pumping gpm			
		Est. Yield 10 gpm: Well water was ft. after hours pumping gpm			
		Bore Hole Diameter 7 in. to ft., and in. to ft.			
WELL WATER TO BE USED AS:		5 Public water supply 8 Air conditioning 11 Injection well			
1 Domestic 3 Feedlot 6 Oil field water supply 9 Dewatering 12 Other (Specify below)					
2 Irrigation 4 Industrial 7 Lawn and garden only 10 Monitoring well					
Was a chemical/bacteriological sample submitted to Department? Yes.....No... X; If yes, mo/day/yr sample was submitted					
Water Well Disinfected? Yes X No					
5 TYPE OF BLANK CASING USED:					
1 Steel 3 RMP (SR) 5 Wrought iron 8 Concrete tile		CASING JOINTS: Glued X Clamped			
2 PVC 4 ABS 6 Asbestos-Cement 9 Other (specify below)		Welded			
Blank casing diameter 4 in. to 56 ft., Dia. in. to ft., Dia. in. to ft.		Threaded			
Casing height above land surface in., weight lbs./ft. Wall thickness or gauge No. 214					
TYPE OF SCREEN OR PERFORATION MATERIAL:					
1 Steel 3 Stainless steel 5 Fiberglass 7 PVC 10 Asbestos-cement					
2 Brass 4 Galvanized steel 6 Concrete tile 8 RMP (SR) 11 Other (specify)					
SCREEN OR PERFORATION OPENINGS ARE:		12 None used (open hole)			
1 Continuous slot 3 Mill slot 5 Gauzed wrapped 8 Saw cut 11 None (open hole)					
2 Louvered shutter 4 Key punched 6 Wire wrapped 9 Drilled holes					
3 Torch cut 10 Other (specify)					
SCREEN-PERFORATED INTERVALS: From 76 ft. to 56 ft., From ft. to ft.					
From ft. to ft., From ft. to ft.					
GRAVEL PACK INTERVALS: From 76 ft. to 25 ft., From ft. to ft.					
From ft. to ft., From ft. to ft.					
6 GROUT MATERIAL: 1 Neat cement 2 Cement grout 3 Bentonite 4 Other					
Grout Intervals: From 25 ft. to 5 ft., From ft. to ft., From ft. to ft.					
What is the nearest source of possible contamination:					
1 Septic tank 4 Lateral lines 7 Pit privy 10 Livestock pens 14 Abandoned water well					
2 Sewer lines 5 Cess pool 8 Sewage lagoon 11 Fuel storage 15 Oil well/Gas well					
3 Watertight sewer lines 6 Seepage pit 9 Feedyard 12 Fertilizer storage 16 Other (specify below)					
13 Insecticide storage					
Direction from well? south		How many feet? 60			
FROM	TO	LITHOLOGIC LOG	FROM	TO	PLUGGING INTERVALS
0	22	top			
22	34	fine sand			
34	39	sandy clay			
39	50	clay and limestone			
50	58	sand			
58	68	sandy clay			
68	72	sand			
72		shale			
7 CONTRACTOR'S OR LANDOWNER'S CERTIFICATION: This water well was (1) constructed, (2) reconstructed, or (3) plugged under my jurisdiction and was completed on (mo/day/year) 10-16-92 and this record is true to the best of my knowledge and belief. Kansas Water Well Contractor's License No. 398 . This Water Well Record was completed on (mo/day/yr) 10-21-92 under the business name of Kelley Drilling Co. by (signature) <i>Richard A. Kelley</i>					
INSTRUCTIONS: Use typewriter or ball point pen. PLEASE PRESS FIRMLY and PRINT clearly. Please fill in blanks, underline or circle the correct answers. Send top three copies to Kansas Department of Health and Environment, Bureau of Water, Topeka, Kansas 66620-0001. Telephone: 913-296-5545. Send one to WATER WELL OWNER and retain one for your records.					