

USE TYPEWRITER OR BALL POINT PEN-PRESS FIRMLY, PRINT CLEARLY.

5 2 8 W 24 SE NE NE
T R EW sec 1/4 1/4 1/4 No.


WATER WELL RECORD
KSA 82a-1201-1215

AAS

Kansas State Dept. Of Health
(Water Well Contractors)
Forbes-Bldg. 740
Topeka, Kansas 66620

1 Location of well:	County Decator	Township name	Fraction SE-NE-NE	Section number 24	Town number 5 S	Range number 28 W
---------------------	--------------------------	---------------	-----------------------------	-----------------------------	---------------------------	-----------------------------

Distance and direction from nearest town or city: 1 1/2 miles SE of Dresden, Ks.	3 Owner of well: Russell Rhodes Dresden, Ks. 67635
Street address of well location if in city:	Address:

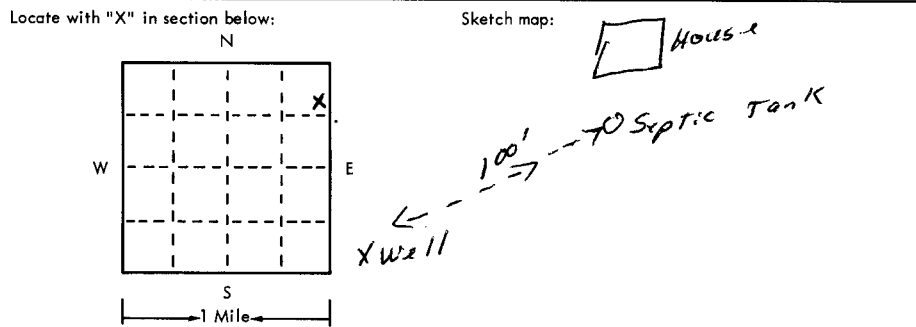

4 Well depth: 136 ft. Date of completion 6-2-76 Well diameter 5 in.
5 <input type="checkbox"/> Cable tool <input type="checkbox"/> Rotary <input type="checkbox"/> Driven <input type="checkbox"/> Dug <input type="checkbox"/> Hollow rod <input type="checkbox"/> Jetted <input type="checkbox"/> Bored <input checked="" type="checkbox"/> Reverse rotary
6 Use: <input checked="" type="checkbox"/> Domestic <input type="checkbox"/> Public supply <input type="checkbox"/> Industry <input type="checkbox"/> Irrigation <input type="checkbox"/> Air conditioning <input type="checkbox"/> Commercial <input type="checkbox"/> Test well <input type="checkbox"/>
7 Casing: Material PVC Height: above below Threaded <input type="checkbox"/> Welded <input checked="" type="checkbox"/> Surface 12 in. Diam. 5 in. Weight 200 LBS PVC 5 in. to 136 depth Drive shoe? <input type="checkbox"/> Yes <input checked="" type="checkbox"/> No 5 in. to 136 ft. depth

2	Type and color of material	From	To
	Topsoil, Clay, silty, brown	0	80
	Clay, Sandy clay, brown	80	88
	Clay, Sandy clay, brown	88	98
	Fine sand, Loose Med Gravel, brown	98	101
	Med. Gravel, Sandy Clay, brown	101	110
	Sandy clay, brown	110	116
	Med Gravel, Sandy clay	116	120
	Med Gravel, Sandy clay, streak Sandstone	120	124
	Rock, whiteish brown, Ochre, yellow	124	130
	Ochre, yellow, Shale, blue	130	136
	BROCK 130'		

8 Screen: Manufacturer Neb. Plastics Type PVC IPS Dia. 5" Slot/gauze unknown Length 20' Set between 116 ft. and 136 ft. Fittings: Gravel pack <input checked="" type="checkbox"/> Yes <input type="checkbox"/> No Size range of material 1-18
9 Static water level: 110 ft. below land surface Date 6-2-76
10 Pumping level below land surfaces: 126 ft. after 8 hrs. pumping 30 g.p.m. ____ ft. after ____ hrs. pumping ____ g.p.m. Estimated maximum yield 30 g.p.m.
11 Water sample submitted: <input type="checkbox"/> Yes <input checked="" type="checkbox"/> No Date _____
12 Well head completion: no <input type="checkbox"/> Pitless adapter <input type="checkbox"/> Inches above grade
13 Well grouted? <input checked="" type="checkbox"/> Yes <input type="checkbox"/> No <input checked="" type="checkbox"/> Neat cement <input type="checkbox"/> Bentonite <input type="checkbox"/> Depth: From 0 ft. to 10 ft.
14 Nearest source of possible contamination: 100 ft. Direction NE Type Septic tank Well disinfected upon completion? <input checked="" type="checkbox"/> Yes <input type="checkbox"/> No
15 Pump: <input checked="" type="checkbox"/> Not installed Manufacturer's name _____ Model number _____ HP _____ Volts _____ Length of drop pipe _____ ft. capacity _____ g.m.p. Type: <input type="checkbox"/> Submersible <input type="checkbox"/> Turbine <input type="checkbox"/> Jet <input type="checkbox"/> Reciprocating <input type="checkbox"/> Centrifugal <input type="checkbox"/> Other

16 Remarks: elevation

Pump not installed by this company, was contracted to another company, unkn.

Topography:
 Hill
 Slope
 Upland
 Valley

17 Water well contractor's certification:
This well was drilled under my jurisdiction and this report is true to the best of my knowledge and belief.

Red Tiger **125**
Business name License No.
Address **Colby, Ks.**
Signed **John Case** Date **8-16-76**
Authorized representative