

1 LOCATION OF WATER WELL:		Fraction	Section Number	Township Number	Range Number
County:	Decatur	se ¼ nw ¼ nw ¼	12	T 5 S	R 29 EW

Distance and direction from nearest town or city street address of well if located within city?
1 mi south and 6 mi east of Dersden, Kansas


2	WATER WELL OWNER:
---	-------------------

RR#, St. Address, Box # :	Mark Meitl
City, State, ZIP Code :	Dresden, Kansas 67635

Board of Agriculture, Division of Water Resources

Application Number:

3 LOCATE WELL'S LOCATION WITH AN "X" IN SECTION BOX:

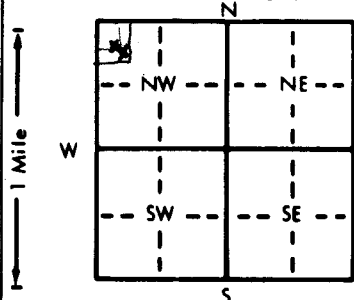

4 DEPTH OF COMPLETED WELL... 67 ft. ELEVATION:

Depth(s) Groundwater Encountered 1. 51 ft. 2. _____ ft. 3. _____ ft.

WELL'S STATIC WATER LEVEL 51 ft. below land surface measured on mo/day/yr

Pump test data: Well water was ft. after hours pumping gpm

Est. Yield 7 . . . gpm: Well water was ft. after hours pumping gpm

Bore Hole Diameter. . . 7 in. to ft., and in. to ft.

WELL WATER TO BE USED AS: 5 Public water supply 8 Air conditioning 11 Injection well

1 Domestic	3 Feedlot	6 Oil field water supply	9 Dewatering	12 Other (Specify below)
------------	-----------	--------------------------	--------------	--------------------------

2 Irrigation 4 Industrial 7 Lawn and garden only 10 Observation well

Was a chemical/bacteriological sample submitted to Department? Yes.....No.....**x**.....; If yes, mo/day/yr sample was sub

mitted Water Well Disinfected? Yes ☒ No

Water Well Disinfected? Yes ☒ No ☐

5 TYPE OF BLANK CASING USED:

1 Steel	3 RMP (SR)	6 Asbestos-Cement	9 Other (specify below)	Welded
2 PVC	4 ABS	7 Fiberglass		Threaded

Blank casing diameter . . . 4 . . . in. to . . . 47 . . . ft. Dia . . . in. to . . . ft. Dia . . . in. to . . . ft.

Casing height above land surface. **12** in., weight lbs./ft. Wall thickness or gauge No. **214**

TYPE OF SCREEN OR PERFORATION MATERIAL: 7 PVC 10 Asbestos-cement

1 Steel	3 Stainless steel	5 Fiberglass	8 RMP (SR)	11 Other (specify) _____
---------	-------------------	--------------	------------	--------------------------

2 Brass	4 Galvanized steel	6 Concrete tile	9 ABS	12 None used (open hole)
---------	--------------------	-----------------	-------	--------------------------

TEEN OR PERFORATION OPENINGS ARE: 5 Gauzed wrapped 8 Saw cut 11 None (open hole)

1 Continuous slot 3 Mill slot 6 Wire wrapped 9 Drilled holes

2 Louvered shutter 4 Key punched 7 Torch cut 10 Other (specify)

NEEN-PERFORATED INTERVALS: From 67 ft. to 47 ft. From ft. to ft.

From ft. to ft. From ft. to ft.

GRAVEL PACK INTERVALS: From 67 ft. to 25 ft., From _____ ft. to _____ ft.

	From	ft. to		ft., From	ft. to	ft.
--	------	--------	--	-----------	--------	-----

ROUT MATERIAL: 1 Neat cement 2 Cement grout 3 Bentonite 4 Other

Grout Intervals: From... 25... ft. to ... 5... ft., From... ft. to... ft., From... ft. to... ft.

What is the nearest source of possible contamination: 10 Livestock pens 14 Abandoned water well

1 Septic tank	4 Lateral lines	7 Pit privy	11 Fuel storage	15 Oil well/Gas well
---------------	-----------------	-------------	-----------------	----------------------

2 Sewer lines 5 Cess pool 8 Sewage lagoon 12 Fertilizer storage 16 Other (specify below)

3 Watertight sewer lines 6 Seepage pit 9 Feedyard 13 Insecticide storage

Direction from well? **east** How many feet? **150**

How many feet? 150

[illegible]

7 **CONTRACTOR'S OR LANDOWNER'S CERTIFICATION:** This water well was (1) constructed, (2) reconstructed, or (3) plugged under my jurisdiction and was completed on (mo/day/year) 12-27-89 and this record is true to the best of my knowledge and belief. Kansas

Water Well Contractor's License No. 398 This Water Well Record was completed on (mo/day/yr) 12-30-89

under the business name of **Kelley Drilling Co.** by (signature) *Richard P. Kelley*

INSTRUCTIONS: Use typewriter or ball point pen. PLEASE PRESS FIRMLY and PRINT clearly. Please fill in blanks, underline or circle the correct answers. Send top three copies to Kansas

Department of Health and Environment, Office of Oil Field and Environmental Geology, Regulation and Permitting Section, Topeka, Kansas 66620-7500, Telephone: 913-862-9360. Send one to WATER WELL OWNER and retain one for your records.

TO WATER WELL OWNER and retain one for your records.