

1 LOCATION OF WATER WELL:		Fraction	Section Number		Township Number		Range Number	
County:	Decatur	$\frac{1}{4}$ NE $\frac{1}{4}$ SW $\frac{1}{4}$	7		5 S		29 E/W	

Distance and direction from nearest town or city street address of well if located within city?


5 miles west Dresden X

2] WATER WELL OWNER:

RR#, St. Address, Box # : **Walter Meitl**
City, State, ZIP Code : **Dresden, Kansas**

Board of Agriculture, Division of Water Resources
Application Number:

3 LOCATE WELL'S LOCATION WITH AN "X" IN SECTION BOX:

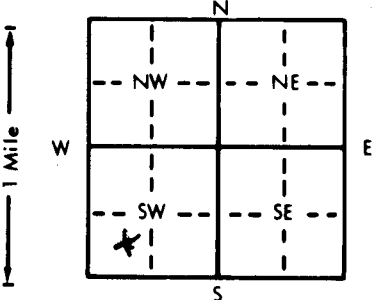

4 DEPTH OF COMPLETED WELL. 32 ft. ELEVATION:

Depth(s) Groundwater Encountered 1. 19 ft. 2. _____ ft. 3. _____ ft.

WELL'S STATIC WATER LEVEL 19 ft. below land surface measured on mo/day/yr _____

Pump test data: Well water was _____ ft. after _____ hours pumping _____ gpm

Est. Yield 4 gpm: Well water was _____ ft. after _____ hours pumping _____ gpm

Bore Hole Diameter 8 in. to 32 ft., and _____ in. to _____ ft.

WELL WATER TO BE USED AS:

<u>Domestic</u>	3 Feedlot	6 Oil field water supply	9 Dewatering	12 Other (Specify below)
2 Irrigation	4 Industrial	7 Lawn and garden only	10 Observation well	

Was a chemical/bacteriological sample submitted to Department? Yes _____ No _____; If yes, mo/day/yr sample was submitted _____

Water Well Disinfected? Yes _____ No _____

5 TYPE OF BLANK CASING USED:

1 Steel 3 RMP (SR) 6 Asbestos-Cement 9 Other (specify below) Welded
 2 PVC 4 ABS 7 Fiberglass Threaded
 Blank casing diameter . . . 5 in. to 12 ft. Dia . . . in. to . . . ft. Dia . . . in. to . . . ft.
 Casing height above land surface . . . 12 in. weight . . . lbs./ft. Wall thickness or gauge No. . . 258

TYPE OF SCREEN OR PERFORATION MATERIAL:

1 Steel 3 Stainless steel 5 Fiberglass 8 RMP (SR) 11 Asbestos cement
2 Brass 4 Galvanized steel 6 Concrete tile 9 ABS 12 Other (specify)
SCREEN OR PERFORATION OPENINGS ARE: 5 Gauzed wrapped 8 Saw cut 11 None (open hole)
1 Continuous slot 3 Mill slot 6 Wire wrapped 9 Drilled holes
2 Louvered shutter 4 Key punched 7 Torch cut 10 Other (specify)

SCREEN OR PERFORATION OPENINGS ARE:

1 Continuous slot 3 Mill slot 6 Wire wrapped 9 Drilled holes 11 None (open hole)

2 Louvered shutter 4 Key punched 7 Torch cut 10 Other (specify)

SCREEN-PERFORATED INTERVALS:

GRAVEL PACK INTERVALS:	From	ft. to	ft., From	ft. to	ft.
	From <u>32</u>	ft. to <u>15</u>	ft., From	ft. to	ft.
	From	ft. to	ft., From	ft. to	ft.

5] GROUT MATERIAL:

Grout intervals: From 15 ft. to 5 ft., From _____ ft. to _____ ft., From _____ ft. to _____ ft.

What is the nearest source of possible contamination:

1 Septic tank	4 Lateral lines	7 Pit privy	11 Fuel storage	14 Abandoned water well
2 Sewer lines	5 Cess pool	8 Sewage lagoon	12 Fertilizer storage	15 Oil well/Gas well
3 Watertight sewer lines	6 Seepage pit	9 Feedyard	13 Insecticide storage	16 Other (specify below)

Direction from well?

FROM	TO	LITHOLOGIC LOG	FROM	TO	LITHOLOGIC LOG
top	14	top soil			
14	27	sand			
27	32	sandy clay and soft limestone			
32		shale			

7 CONTRACTOR'S OR LANDOWNER'S CERTIFICATION: This water well was (1) constructed, (2) reconstructed, or (3) plugged under my jurisdiction and was

completed on (mo/day/year) 10-5-81 and this record is true to the best of my knowledge and belief. Kansas
Water Well Contractor's License No. 398 This Water Well Record was completed on (mo/day/yr) 10-14-81
under the business name of Kelley Drilling Co. by (signature) R. Kelley

INSTRUCTIONS: Use typewriter or ball point pen, PLEASE PRESS FIRMLY and PRINT clearly. Please fill in blanks; underline or circle the correct answers. Send top three copies to Kansas Department of Health and Environment, Division of Environment, Environmental Geology Section, Topeka, KS 66620. Send one to WATER WELL OWNER and retain one for your records.