


mw-1

1 LOCATION OF WATER WELL: Fraction SE 1/4 SE 1/4 NW 1/4 Section Number 33 Township Number T 5 S Range Number R 3

Distance and direction from nearest town or city street address of well if located within city? 603 Lincoln, Concordia, Ks corner of 5th street + Lincoln

2 WATER WELL OWNER: City of Concordia Attn: Chad Olsen Board of Agriculture, Division of Water Resources RR#, St. Address, Box #: P.O. Box 603 Concordia, Ks 66901 Application Number: City, State, ZIP Code: P.O. Box 603 Concordia, Ks 66901

3 LOCATE WELL'S LOCATION WITH AN "X" IN SECTION BOX:

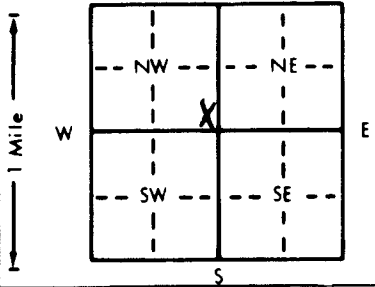

4 DEPTH OF COMPLETED WELL: 30 ft. ELEVATION: Depth(s) Groundwater Encountered 1. 23.3 ft. 2. ft. 3. ft. WELL'S STATIC WATER LEVEL 22.10 ft. below land surface measured on mo/day/yr 7/9/96 Pump test data: Well water was ft. after hours pumping gpm Est. Yield gpm: Well water was ft. after hours pumping gpm Bore Hole Diameter 8.625 in. to 30 ft. and in. to ft. WELL WATER TO BE USED AS: 5 Public water supply 8 Air conditioning 11 Injection well 1 Domestic 3 Feedlot 6 Oil field water supply 9 Dewatering 12 Other (Specify below) 2 Irrigation 4 Industrial 7 Lawn and garden only 10 Monitoring well mw-1 Was a chemical/bacteriological sample submitted to Department? Yes No X If yes, mo/day/yr sample was submitted Water Well Disinfected? Yes No X

5 TYPE OF BLANK CASING USED: 1 Steel 3 RMP (SR) 5 Wrought iron 8 Concrete tile CASING JOINTS: Glued Clamped 2 PVC 4 ABS 6 Asbestos-Cement 9 Other (specify below) Welded 7 Fiberglass Threaded

Blank casing diameter 2 in. to 20 ft. Dia in. to ft. Dia in. to ft. Casing height above land surface 0 in., weight SCH 40 PVC lbs./ft. Wall thickness or gauge No.

TYPE OF SCREEN OR PERFORATION MATERIAL: 1 Steel 3 Stainless steel 5 Fiberglass 8 RMP (SR) 11 Other (specify below) 2 Brass 4 Galvanized steel 6 Concrete tile 9 ABS 12 None used (open hole)

SCREEN OR PERFORATION OPENINGS ARE: 1 Continuous slot 3 Mill slot 5 Gauzed wrapped 8 Saw cut 11 None (open hole) 2 Louvered shutter 4 Key punched 6 Wire wrapped 9 Drilled holes 7 Torch cut 10 Other (specify)

SCREEN-PERFORATED INTERVALS: From 20 ft. to 30 ft. From ft. to ft. From ft. to ft. GRAVEL PACK INTERVALS: From 18 ft. to 30 ft. From ft. to ft. From ft. to ft.

6 GROUT MATERIAL: 1 Neat cement 2 Cement grout 3 Bentonite 4 Other Grout intervals: From 0 ft. to 16 ft. From 16 ft. to 18 ft. From ft. to ft.

What is the nearest source of possible contamination: 1 Septic tank 4 Lateral lines 7 Pit privy 10 Livestock pens 14 Abandoned water well 2 Sewer lines 5 Cess pool 8 Sewage lagoon 11 Fuel storage 15 Oil well/Gas well 3 Watertight sewer lines 6 Seepage pit 9 Feedyard 12 Fertilizer storage 16 Other (specify below) 13 Insecticide storage

Direction from well? How many feet? Contaminated site

Table with columns: FROM, TO, LITHOLOGIC LOG, FROM, TO, SIEVE SIZES. Rows include: GL 1.00 Asphalt, 1.00 2.50 fill, 2.50 13.00 Silty Clay (CL), 13.00 30.00 Clayey Silt (ML), 30.00 TD End of borehole. Includes a note: Flush Mount Waiver 5/14/96 Don Taylor

7 CONTRACTOR'S OR LANDOWNER'S CERTIFICATION: This water well was (1) constructed, (2) reconstructed, or (3) plugged under my jurisdiction and was completed on (mo/day/year) 5/21/96 and this record is true to the best of my knowledge and belief. Kansas Water Well Contractor's License No 585 This Water Well Record was completed on (mo/day/yr) 7/22/96 under the business name of Associated Environmental, Inc. by (signature) D. Johnson for Darin Duncan