

CORRECTION TO WATER WELL RECORD (WWC-5)

The following correction(s) was made to the attached WWC-5 log, in order to file the item or to rectify lacking or incorrect information.

Fraction (1/4 1/4 1/4) Section-Township-Range changed:

listed as NE SW SE, 32-56S-3W

changed to SW NE SW, 33-55-SW

Other changes: Initial statements: _____

Changed to: _____

Comments: _____

verification method: Well address on form, Concordia city map on internet,
and Concordia 1:24,000 topo. map. initials: DR date: 8/27/99


submitted by: Kansas Geological Survey, Data Resources Library, 1930 Constant Ave., Lawrence, KS 66047-3726
to: Kansas Dept of Health & Environment Bureau of Water Industrial Programs, Bldg 283, Forbes Field, KS 66620

1 LOCATION OF WATER WELL: Fraction NE 1/4 SW 1/4 SE 1/4 Section Number 32 Township Number T 56 S Range Number R 3 E/W
 County: Cloud

Distance and direction from nearest town or city street address of well if located within city?
 304 W. Seventh St., Concordia, KS

2 WATER WELL OWNER: Ray & Peggy Doyen
 RR#, St. Address, Box # : RR #3, Box 26 Board of Agriculture, Division of Water Resources
 City, State, ZIP Code : Concordia, KS 66901 Application Number:

3 LOCATE WELL'S LOCATION WITH AN "X" IN SECTION BOX: 4 DEPTH OF COMPLETED WELL: 90 ft. ELEVATION:

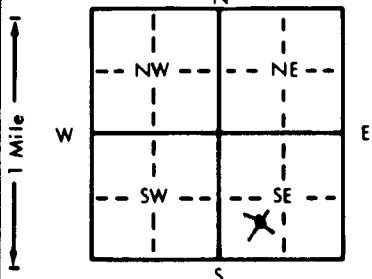

Depth(s) Groundwater Encountered 1. ft. 2. ft. 3. ft.
 WELL'S STATIC WATER LEVEL . . . 55 ft. below land surface measured on mo/day/yr . . . 7/16/99
 Pump test data: Well water was ft. after hours pumping gpm
 Est. Yield 30-50 . gpm: Well water was ft. after hours pumping gpm
 Bore Hole Diameter . . . 9 in. to . . . 9.2 ft., and in. to ft.
 WELL WATER TO BE USED AS: 5 Public water supply 8 Air conditioning 11 Injection well
 1 Domestic 3 Feedlot 6 Oil field water supply 9 Dewatering 12 Other (Specify below)
 2 Irrigation 4 Industrial X Lawn and garden only 10 Monitoring well
 Was a chemical/bacteriological sample submitted to Department? Yes No X; If yes, mo/day/yr sample was submitted
 Water Well Disinfected? Yes X No

5 TYPE OF BLANK CASING USED: 5 Wrought iron 8 Concrete tile CASING JOINTS: Glued X Clamped
 1 Steel 3 RMP (SR) 6 Asbestos-Cement 9 Other (specify below) Welded
X PVC 4 ABS 7 Fiberglass Threaded

Blank casing diameter . . . 5 in. to . . . 80 ft., Dia in. to ft., Dia in. to ft.
 Casing height above land surface 12 in., weight . . . 2.37 lbs./ft. Wall thickness or gauge No. . . . 2.14

TYPE OF SCREEN OR PERFORATION MATERIAL: X PVC 10 Asbestos-cement
 1 Steel 3 Stainless steel 5 Fiberglass 8 RMP (SR) 11 Other (specify)
 2 Brass 4 Galvanized steel 6 Concrete tile 9 ABS 12 None used (open hole)

SCREEN OR PERFORATION OPENINGS ARE: 5 Gauzed wrapped 8 Saw cut 11 None (open hole)
 1 Continuous slot X Mill slot 6 Wire wrapped 9 Drilled holes
 2 Louvered shutter 4 Key punched 7 Torch cut 10 Other (specify)

SCREEN-PERFORATED INTERVALS: From . . . 80 ft. to . . . 90 ft., From ft. to ft.
 From ft. to ft., From ft. to ft.
 GRAVEL PACK INTERVALS: From . . . 20 ft. to . . . 90 ft., From ft. to ft.
 From ft. to ft., From ft. to ft.

6 GROUT MATERIAL: 1 Neat cement 2 Cement grout X Bentonite 4 Other
 Grout Intervals: From . . . 0 ft. to . . . 20 ft., From ft. to ft., From ft. to ft.

What is the nearest source of possible contamination:
 1 Septic tank 4 Lateral lines 7 Pit privy 10 Livestock pens 14 Abandoned water well
X Sewer lines 5 Cess pool 8 Sewage lagoon 11 Fuel storage 15 Oil well/Gas well
 3 Watertight sewer lines 6 Seepage pit 9 Feedyard 12 Fertilizer storage 16 Other (specify below)
 13 Insecticide storage
 Direction from well? West How many feet? 100

FROM	TO	LITHOLOGIC LOG	FROM	TO	PLUGGING INTERVALS
0	2	Topsoil			
2	13	Brown Clay			
13	40	Soft Tan Sandstone			
40	51	Blue Shale			
51	80	Soft Tan Sandstone			
80	90	Semi-Soft, Reddish, Tan Sandstone			
90	92	Blue & Red Shale			

7 CONTRACTOR'S OR LANDOWNER'S CERTIFICATION: This water well was X constructed, (2) reconstructed, or (3) plugged under my jurisdiction and was completed on (mo/day/year) . . . 7/17/99 and this record is true to the best of my knowledge and belief. Kansas Water Well Contractor's License No. . . . 138 This Water Well Record was completed on (mo/day/yr) . . . 8/4/99 under the business name of PETERSON IRRIGATION, INC. by (signature) *Mike Peterson*

OFFICE USE ONLY
T
R
EW
SEC.