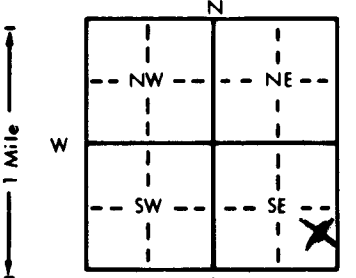


1 LOCATION OF WATER WELL: Fraction Section Number Township Number Range Number
 County: Cloud NE 1/4 SE 1/4 SE 1/4 33 T 5 S R 3 ~~EW~~

Distance and direction from nearest town or city street address of well if located within city?
In City limits - 403 E. 9th, Concordia, KS

2 WATER WELL OWNER: Weisner Rentals
 RR#, St. Address, Box # : 403 E. Ninth Board of Agriculture, Division of Water Resources
 City, State, ZIP Code : Concordia, KS 66901 Application Number:

3 LOCATE WELL'S LOCATION WITH AN "X" IN SECTION BOX:


4 DEPTH OF COMPLETED WELL... 54 ft. ELEVATION:
 Depth(s) Groundwater Encountered 1. ft. 2. ft. 3. ft.
 WELL'S STATIC WATER LEVEL... 23 ft. below land surface measured on mo/day/yr... 9/22/99
 Pump test data: Well water was ft. after hours pumping gpm
 Est. Yield . 20 gpm: Well water was ft. after hours pumping gpm
 Bore Hole Diameter... 9 in. to 56 ft., and... in. to ft.
 WELL WATER TO BE USED AS: 5 Public water supply 8 Air conditioning 11 Injection well
 1 Domestic 3 Feedlot 6 Oil field water supply 9 Dewatering 12 Other (Specify below)
 2 Irrigation 4 Industrial XX Lawn and garden only 10 Monitoring well
 Was a chemical/bacteriological sample submitted to Department? Yes..... No. X.....; If yes, mo/day/yr sample was submitted
 Water Well Disinfected? Yes X No

5 TYPE OF BLANK CASING USED: 5 Wrought iron 8 Concrete tile CASING JOINTS: Glued X Clamped
 1 Steel 3 RMP (SR) 6 Asbestos-Cement 9 Other (specify below) Welded
XXPVC 4 ABS 7 Fiberglass Threaded
 Blank casing diameter... 5 in. to 44 ft., Dia... in. to ft., Dia... in. to ft.
 Casing height above land surface... 12 in., weight 2.37 lbs./ft. Wall thickness or gauge No. 214
 TYPE OF SCREEN OR PERFORATION MATERIAL: XPVC 10 Asbestos-cement
 1 Steel 3 Stainless steel 5 Fiberglass 8 RMP (SR) 11 Other (specify)
 2 Brass 4 Galvanized steel 6 Concrete tile 9 ABS 12 None used (open hole)
 SCREEN OR PERFORATION OPENINGS ARE: 5 Gauzed wrapped 8 Saw cut 11 None (open hole)
 1 Continuous slot X Mill slot 6 Wire wrapped 9 Drilled holes
 2 Louvered shutter 4 Key punched 7 Torch cut 10 Other (specify)
 SCREEN-PERFORATED INTERVALS: From... 44 ft. to 54 ft., From... ft. to... ft.
 GRAVEL PACK INTERVALS: From... 21 ft. to 54 ft., From... ft. to... ft.
 From... ft. to... ft., From... ft. to... ft.

6 GROUT MATERIAL: 1 Neat cement 2 Cement grout X Bentonite 4 Other
 Grout intervals: From... 1 ft. to 21 ft., From... ft. to... ft., From... ft. to... ft.
 What is the nearest source of possible contamination: 10 Livestock pens 14 Abandoned water well
 1 Septic tank 4 Lateral lines 7 Pit privy 11 Fuel storage 15 Oil well/Gas well
X Sewer lines 5 Cess pool 8 Sewage lagoon 12 Fertilizer storage 16 Other (specify below)
 3 Watertight sewer lines 6 Seepage pit 9 Feedyard 13 Insecticide storage
 Direction from well? West How many feet? 50

FROM	TO	LITHOLOGIC LOG	FROM	TO	PLUGGING INTERVALS
0	2	TOPSOIL			
2	46	BROWN, SILTY CLAY			
46	54	FINE TO MEDIUM TAN SAND			
54	56	BLUE SHALE			

7 CONTRACTOR'S OR LANDOWNER'S CERTIFICATION: This water well was X constructed, (2) reconstructed, or (3) plugged under my jurisdiction and was completed on (mo/day/year) 9/22/99 and this record is true to the best of my knowledge and belief. Kansas Water Well Contractor's License No. 138 This Water Well Record was completed on (mo/day/yr) 9/27/99 under the business name of PETERSON IRRIGATION, INC. by (signature) Mike Peterson

OFFICE USE ONLY
T
R
EW
SEC.