


1 LOCATION OF WATER WELL: County: Cloud Fraction: SE 1/4 SE 1/4 NE 1/4 Section Number: 33 Township Number: T 5 S Range Number: R 3 E (W)

Distance and direction from nearest town or city street address of well if located within city?
817 E. 6th + Matthew

2 WATER WELL OWNER: Dick Swanson
 RR#, St. Address, Box #: 817 E. 6th + Matthew
 City, State, ZIP Code: Concordia, KS 66901
 Board of Agriculture, Division of Water Resources
 Application Number:

3 LOCATE WELL'S LOCATION WITH AN "X" IN SECTION BOX:

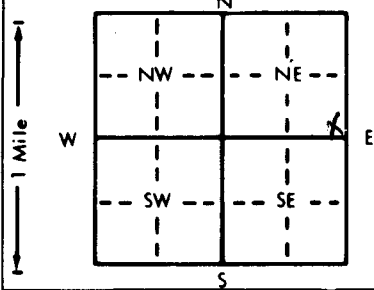

4 DEPTH OF COMPLETED WELL: 20 ft. ELEVATION:
 Depth(s) Groundwater Encountered 1. 1 ft. 2. 1 ft. 3. 1 ft.
 WELL'S STATIC WATER LEVEL: 999 ft. below land surface measured on mo/day/yr
 Pump test data: Well water was 1 ft. after 1 hours pumping 1 gpm
 Est. Yield 1 gpm: Well water was 1 ft. after 1 hours pumping 1 gpm
 Bore Hole Diameter: 8 in. to 70 ft., and 1 in. to 1 ft.
 WELL WATER TO BE USED AS:
 1 Domestic 1 Irrigation 1 Industrial 1 Lawn and garden only
 Was a chemical/bacteriological sample submitted to Department? Yes 1 No X; If yes, mo/day/yr sample was submitted
 Water Well Disinfected? Yes X No

5 TYPE OF BLANK CASING USED:
 1 Steel 2 PVC
 3 RMP (SR) 4 ABS
 5 Wrought iron 6 Asbestos-Cement 7 Fiberglass
 8 Concrete tile 9 Other (specify below)
 CASING JOINTS: Glued X Clamped
 Welded
 Threaded
 Blank casing diameter 5 in. to 5 ft., Dia 5 in. to 5 ft., Dia 5 in. to 5 ft.
 Casing height above land surface 36 in., weight 36 lbs./ft. Wall thickness or gauge No.
 TYPE OF SCREEN OR PERFORATION MATERIAL:
 1 Steel 3 Stainless steel 5 Fiberglass 7 PVC 10 Asbestos-cement
 2 Brass 4 Galvanized steel 6 Concrete tile 8 RMP (SR) 11 Other (specify)
 9 ABS 12 None used (open hole)
 SCREEN OR PERFORATION OPENINGS ARE:
 1 Continuous slot 3 Mill slot 5 Gauzed wrapped 8 Saw cut 11 None (open hole)
 2 Louvered shutter 4 Key punched 6 Wire wrapped 9 Drilled holes
 7 Torch cut 10 Other (specify)

6 GROUT MATERIAL: 3 Bentonite
 1 Neat cement 2 Cement grout 4 Other
 What is the nearest source of possible contamination:
 1 Septic tank 4 Lateral lines 7 Pit privy 10 Livestock pens 14 Abandoned water well
 2 Sewer lines 5 Cess pool 8 Sewage lagoon 11 Fuel storage 15 Oil well/Gas well
 3 Watertight sewer lines 6 Seepage pit 9 Feedyard 12 Fertilizer storage 16 Other (specify below)
 13 Insecticide storage Unknown
 Direction from well? How many feet?

FROM	TO	LITHOLOGIC LOG	FROM	TO	PLUGGING INTERVALS
0	10	Silt, Dark Brown to Light Tan			
10	20	Clay, Tan, very silty			
20	30	Sand, fine grained			
30	45	Sand, Gray			
45	70	Sand, Gray			

7 CONTRACTOR'S OR LANDOWNER'S CERTIFICATION: This water well was 1 constructed, (2) reconstructed, or (3) plugged under my jurisdiction and was completed on (mo/day/year) 5-25-2000 and this record is true to the best of my knowledge and belief. Kansas Water Well Contractor's License No. 527 This Water Well Record was completed on (mo/day/yr) 6-16-2000 under the business name of GeoCore Services, Inc. by (signature) Dale Kell